


WATER WORKS & SEWER BOARD
CITY OF ANNISTON
CHOCOLOCCO WWTP
IMPROVEMENTS
ANNISTON, ALABAMA

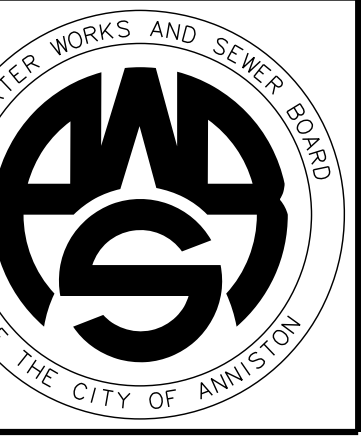


PROJECT NO.	98062	
DESIGNED	PGR	
DRAWN	MDS	
CHECKED	RUH	
APPROVED		
DATE	JULY, 1999	
REVISIONS		
NO.	DATE	DESCRIPTION
1	NOV. 2006	RECORD DRAWING

RECORD DRAWING


HEADWORKS
BUILDING MECHANICAL
PLAN & SECTIONS

SHEET NO.
C3.01


SEQUENCE 29 OF 84

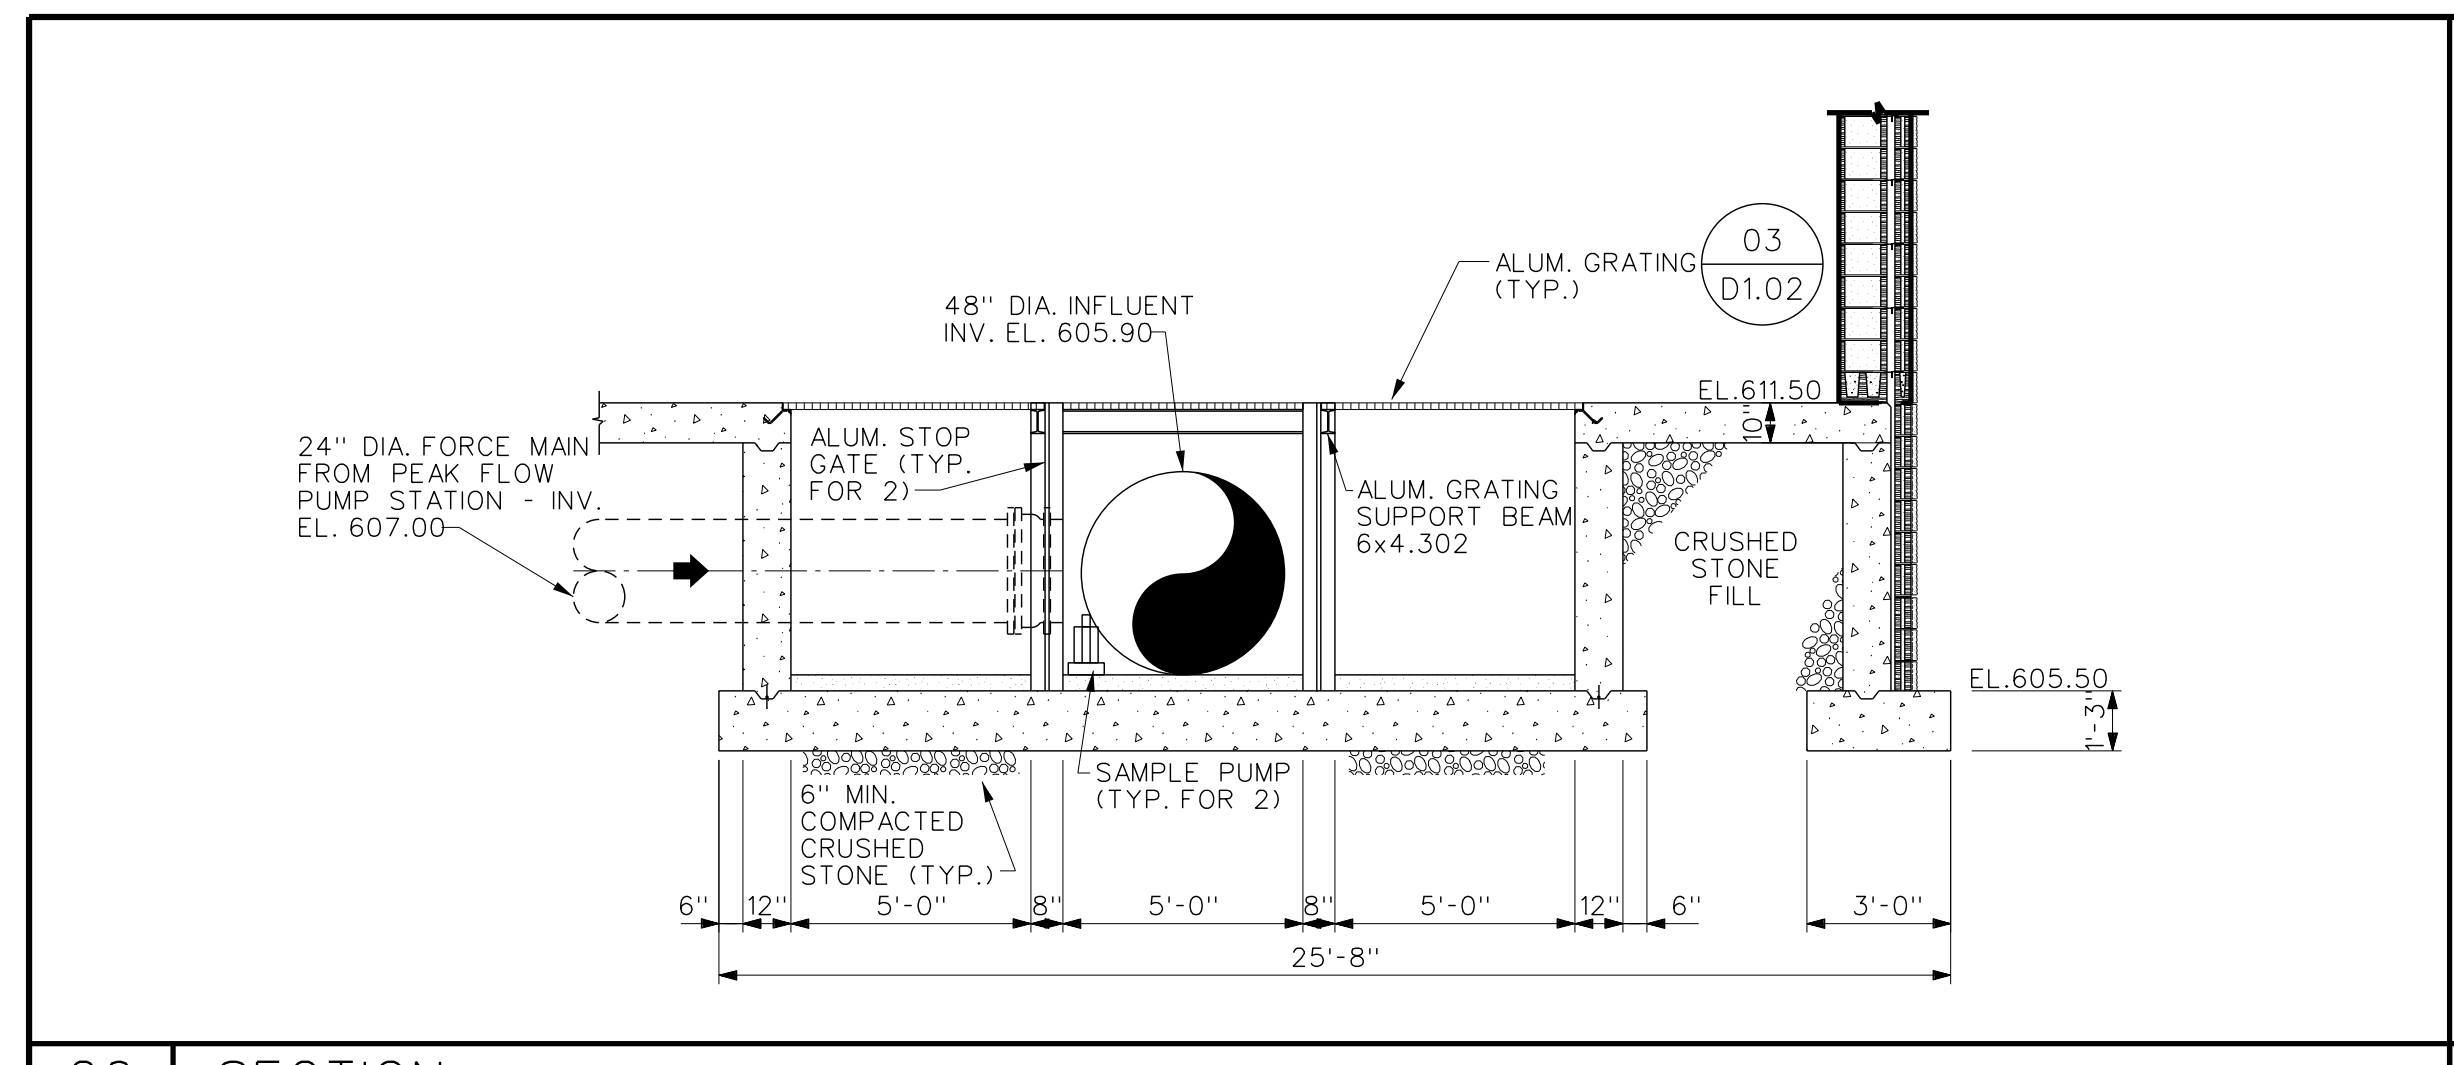

20 SECTION SCALE: 1/4" = 1'-0"

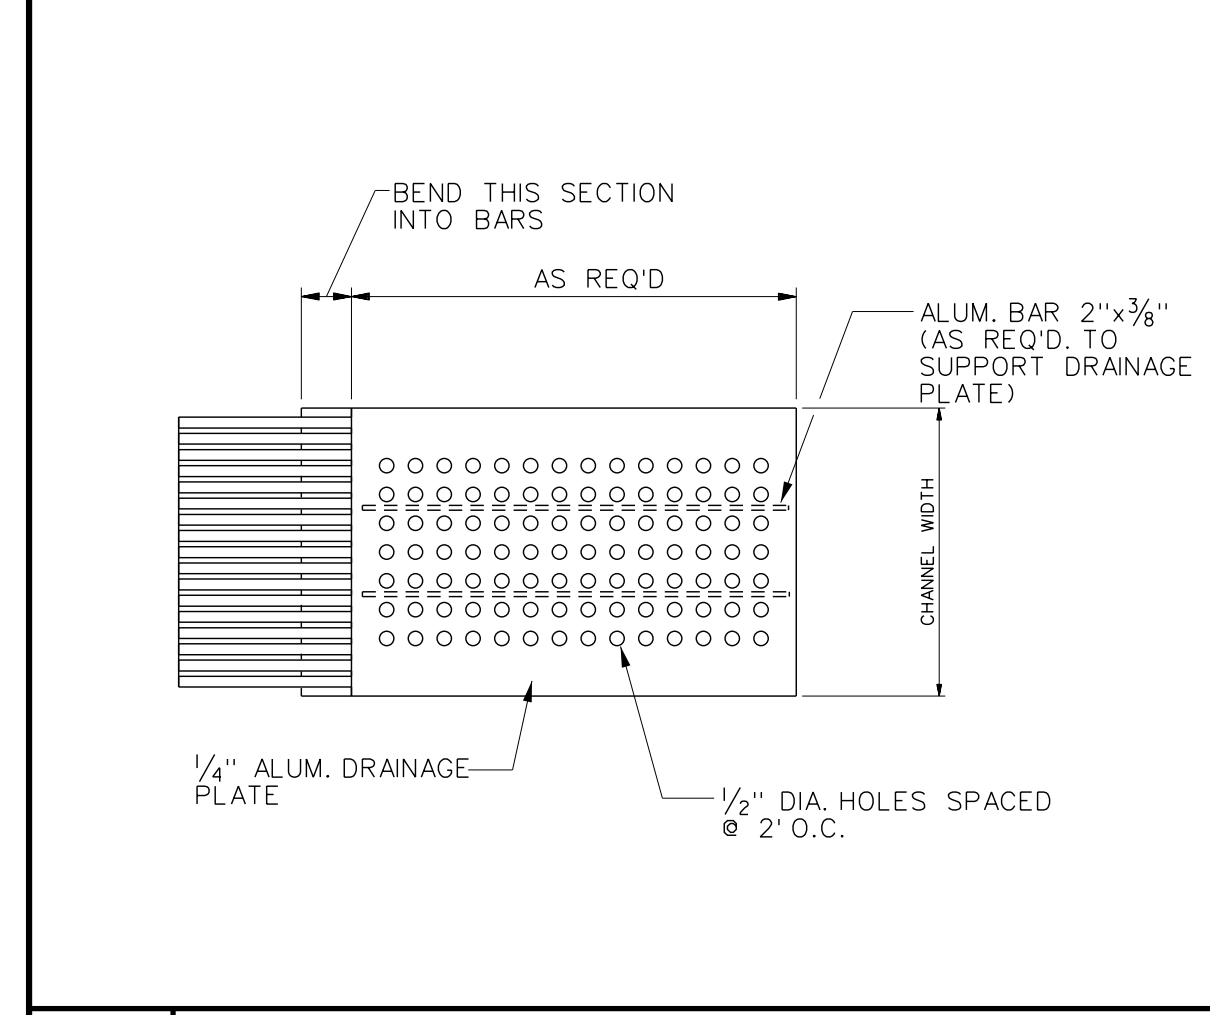


15 DRAINAGE PLATE DETAIL NO SCALE

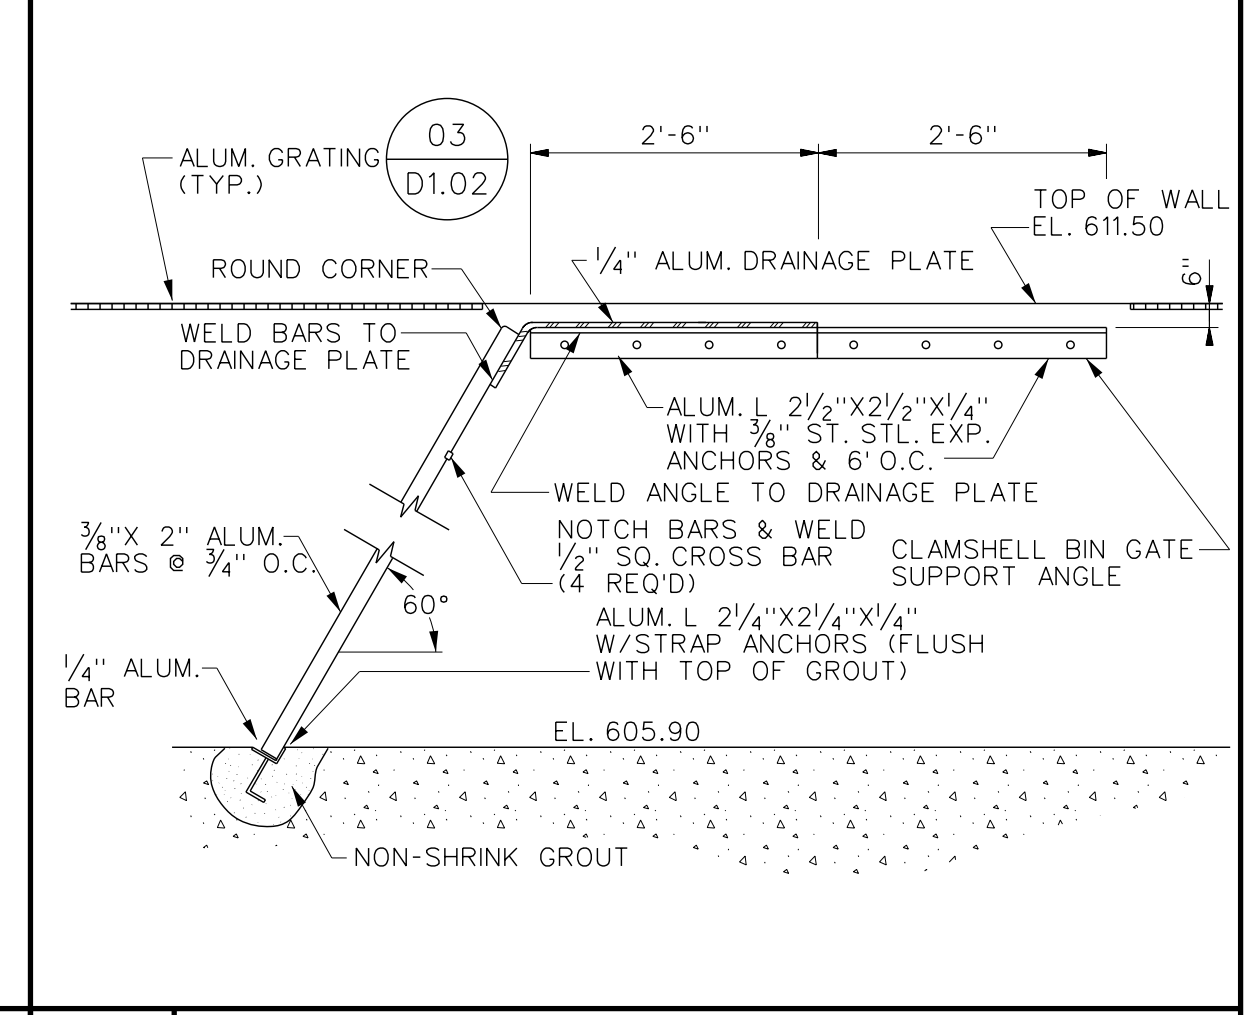


14 BAR SCREEN NO SCALE

- ① 48" D.I. WALL PIPE, PE-WS-MJ
 ② 24" D.I. WALL PIPE, PE-WS-MJ, INV. EL. 607.00
 ③ 4" D.I. WYE, MJ
 ④ 4" D.I. WALL PIPE, PE-WS-MJ
 ⑤ 4" D.I. CROSS, ALL FLG
 ⑥ 4" D.I. 90° BEND, FLG-FLG
 ⑦ 4" D.I. BLIND FLANGE
 ⑧ 4" D.I. PIPE, FLG-VGER
 ⑨ 4" D.I. GATE VALVE, FLG-FLG
 ⑩ 4" VICTAULIC COUPLING
 ⑪ 4" D.I. 90° BEND, MJ-MJ
 ⑫ 4" D.I. WALL PIPE, PE-WS-FLG

04 FITTINGS LIST NO SCALE

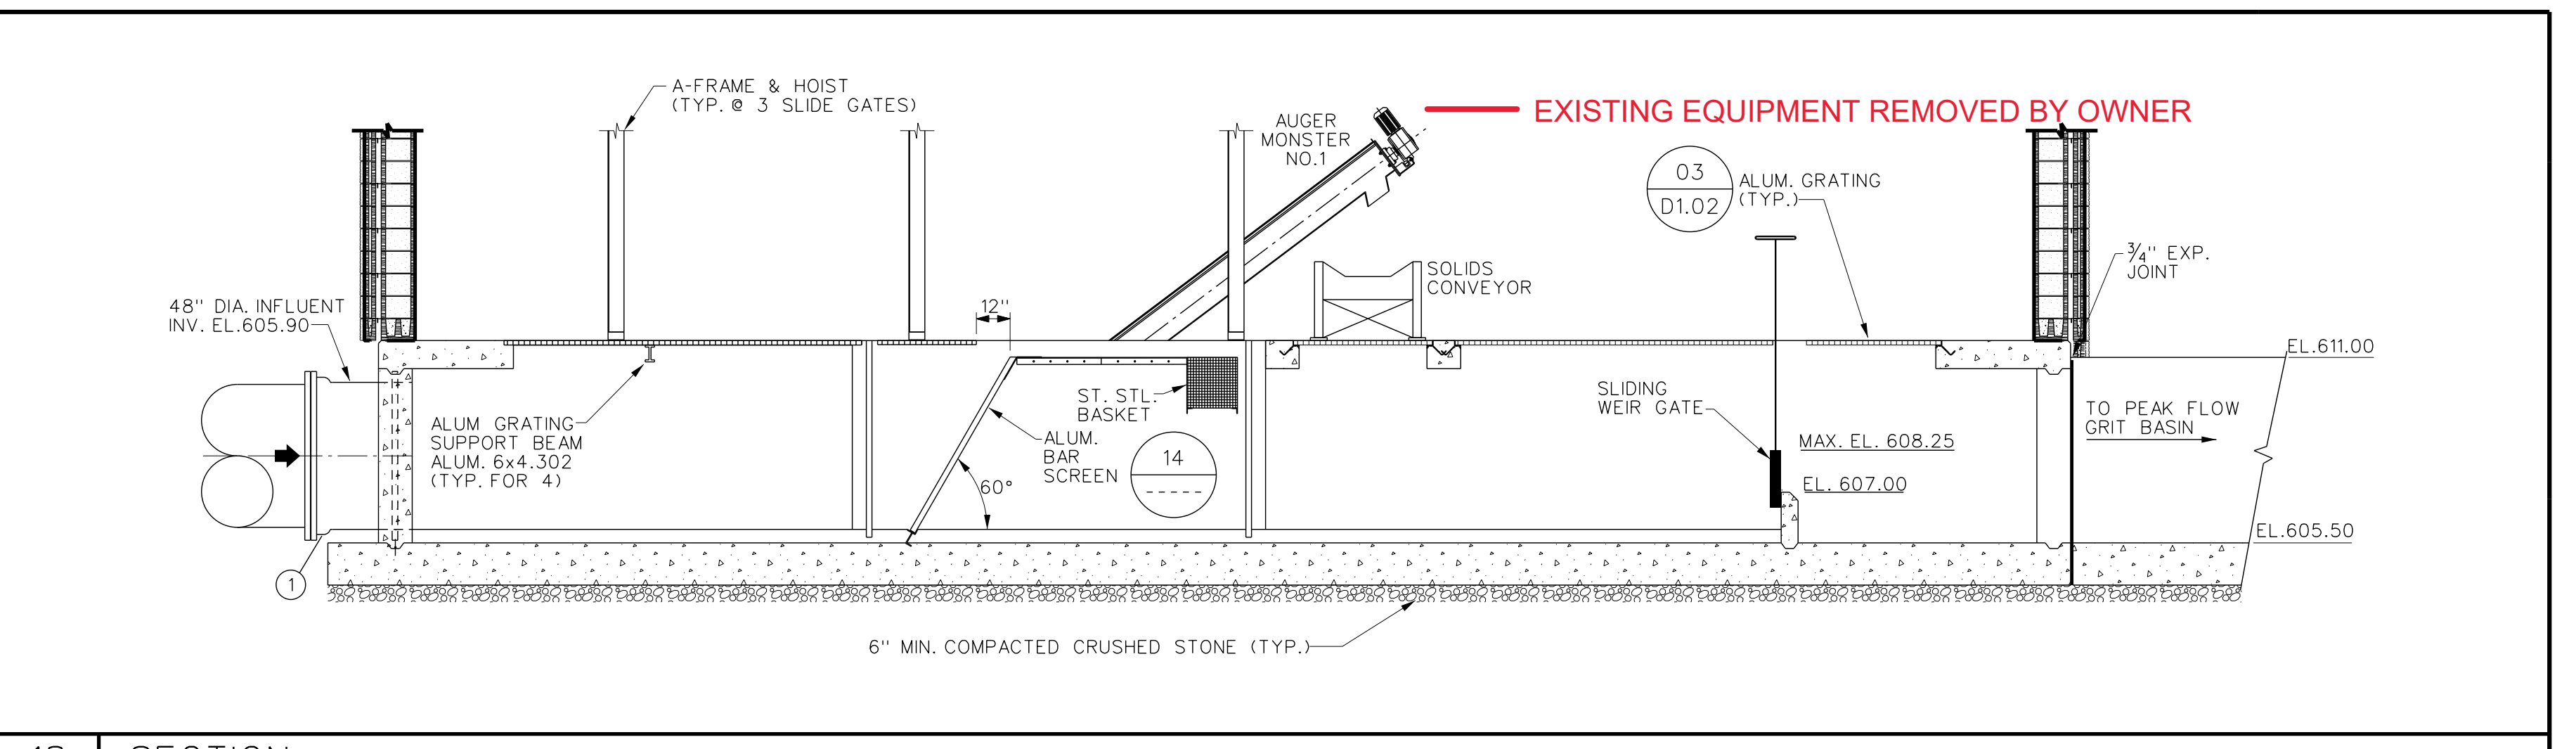

18 SECTION SCALE: 1/4" = 1'-0"

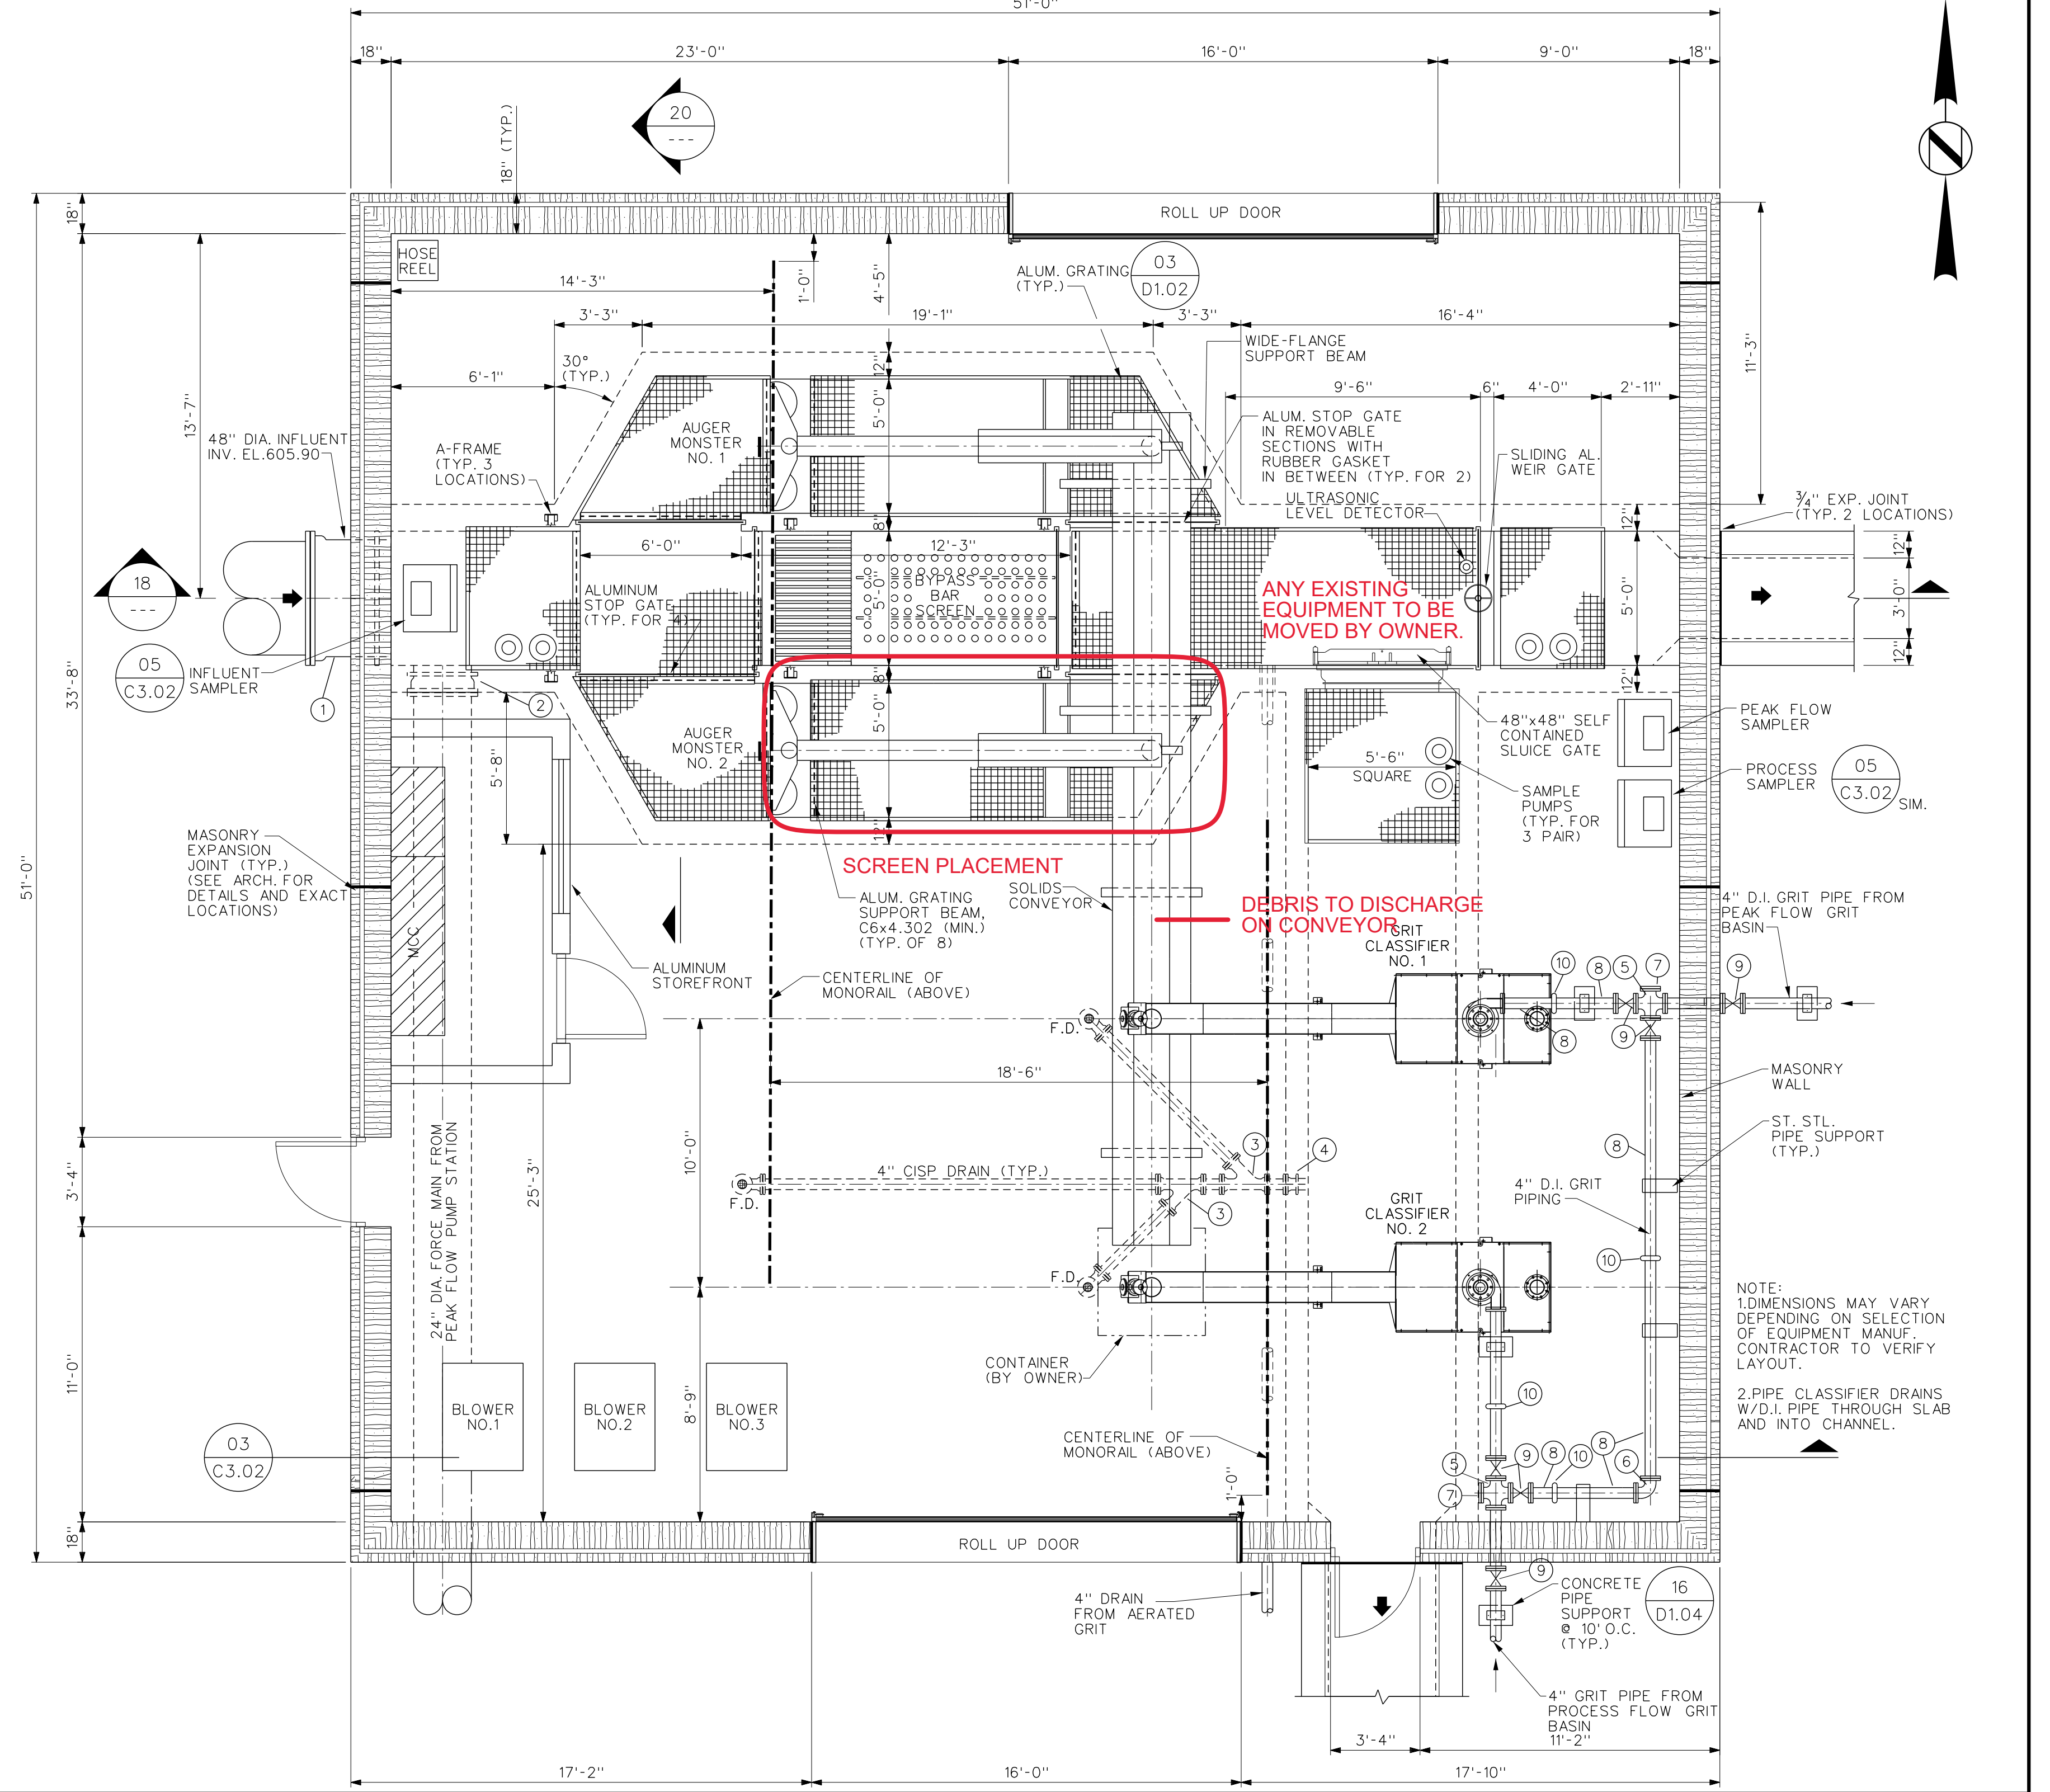

03 PLAN SCALE: 1/4" = 1'-0"

8/14/2013 9:45:54 AM P:\projects\choco\choco\anniston\98062\CAD\records\dwg\98062c301.dwg