


WATER WORKS & SEWER BOARD  
CITY OF ANNISTON  
CHOCOLOCCO WWTP  
IMPROVEMENTS  
ANNISTON, ALABAMA

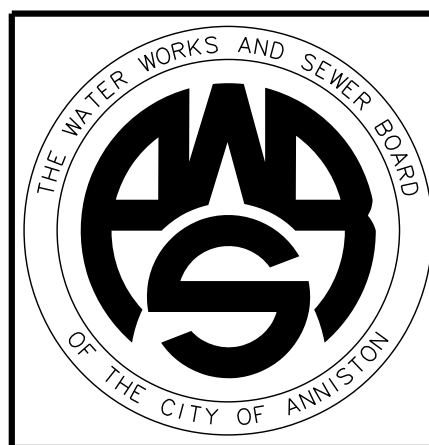

PROJECT NO.		98062
DESIGNED		BKP
DRAWN		MDS
CHECKED		RUH
APPROVED		
DATE		JULY, 1999
REVISIONS		
NO.	DATE	DESCRIPTION
1	NOV. 2006	RECORD DRAWING


RECORD  
DRAWING

SHEET TITLE  
HYDRAULIC PROFILE


SHEET NO.  
C1.04

SEQUENCE 4 OF 84

PEAK FLOW FLOW PROFILE

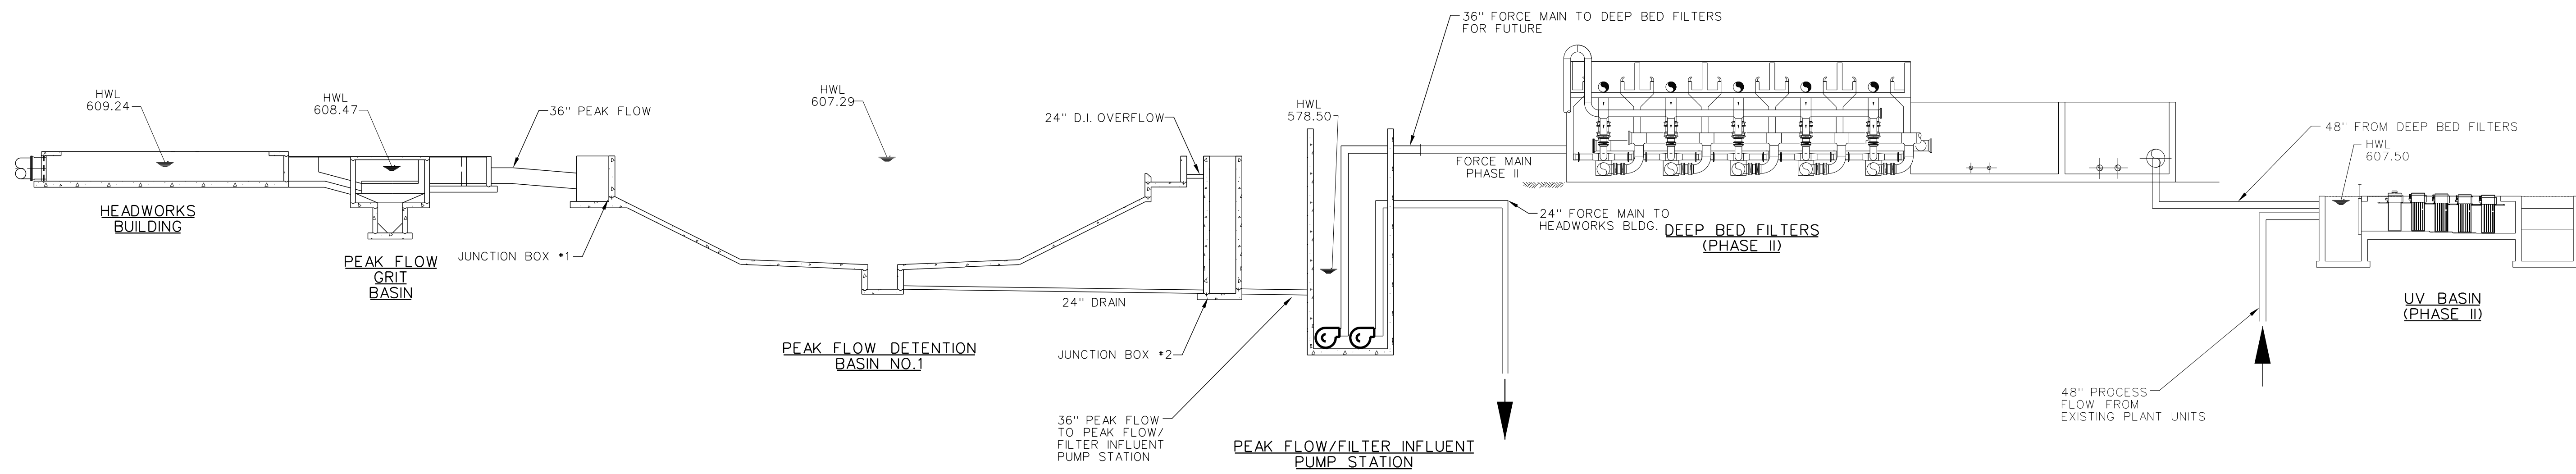

PROCESS FLOW PROFILE

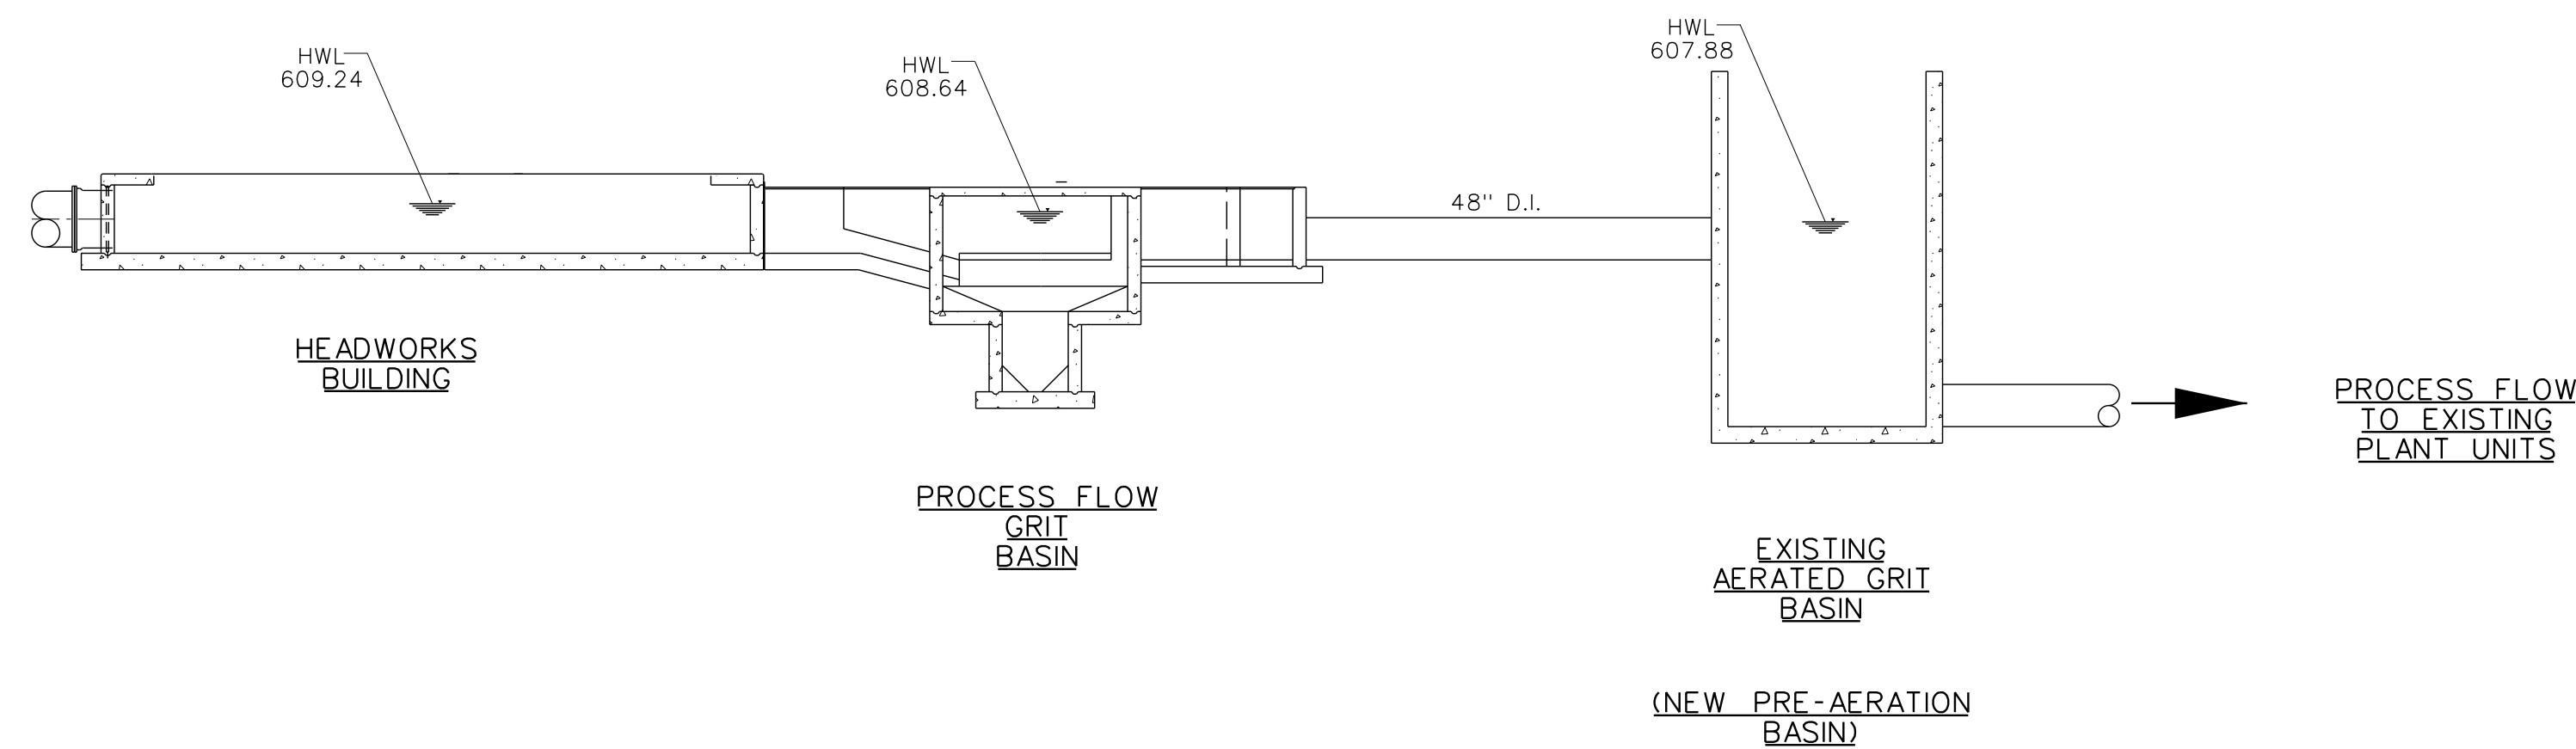

NOTE:  
HYDRAULIC PROFILE SHOWN IS BASED ON  
36 MGD INTO THE HEADWORKS BUILDING  
WITH 15 MGD THROUGH THE PEAK FLOW  
TRAIN AND 21 MGD THROUGH THE  
PROCESS FLOW TRAIN.