


WATER WORKS & SEWER BOARD
CITY OF ANNISTON
CHOCOLOCCO WWTP
IMPROVEMENTS
ANNISTON, ALABAMA

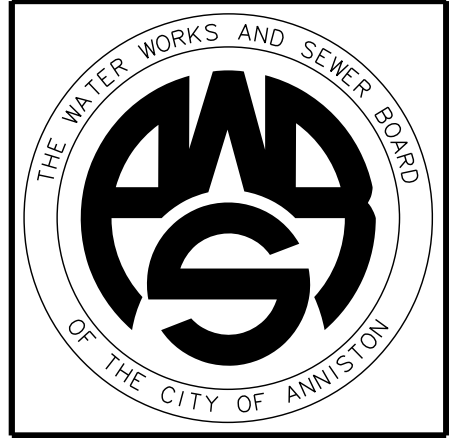


PROJECT NO.	98062	
DESIGNED	PGR	
DRAWN	MDS	
CHECKED	RUH	
APPROVED		
DATE	JULY, 1999	
NO.	DATE	DESCRIPTION
1	NOV. 2006	RECORD DRAWING

RECORD DRAWING


HEADWORKS
BUILDING MECHANICAL
PLAN & SECTIONS

SHEET NO. **C3.01**


SEQUENCE 29 OF 84

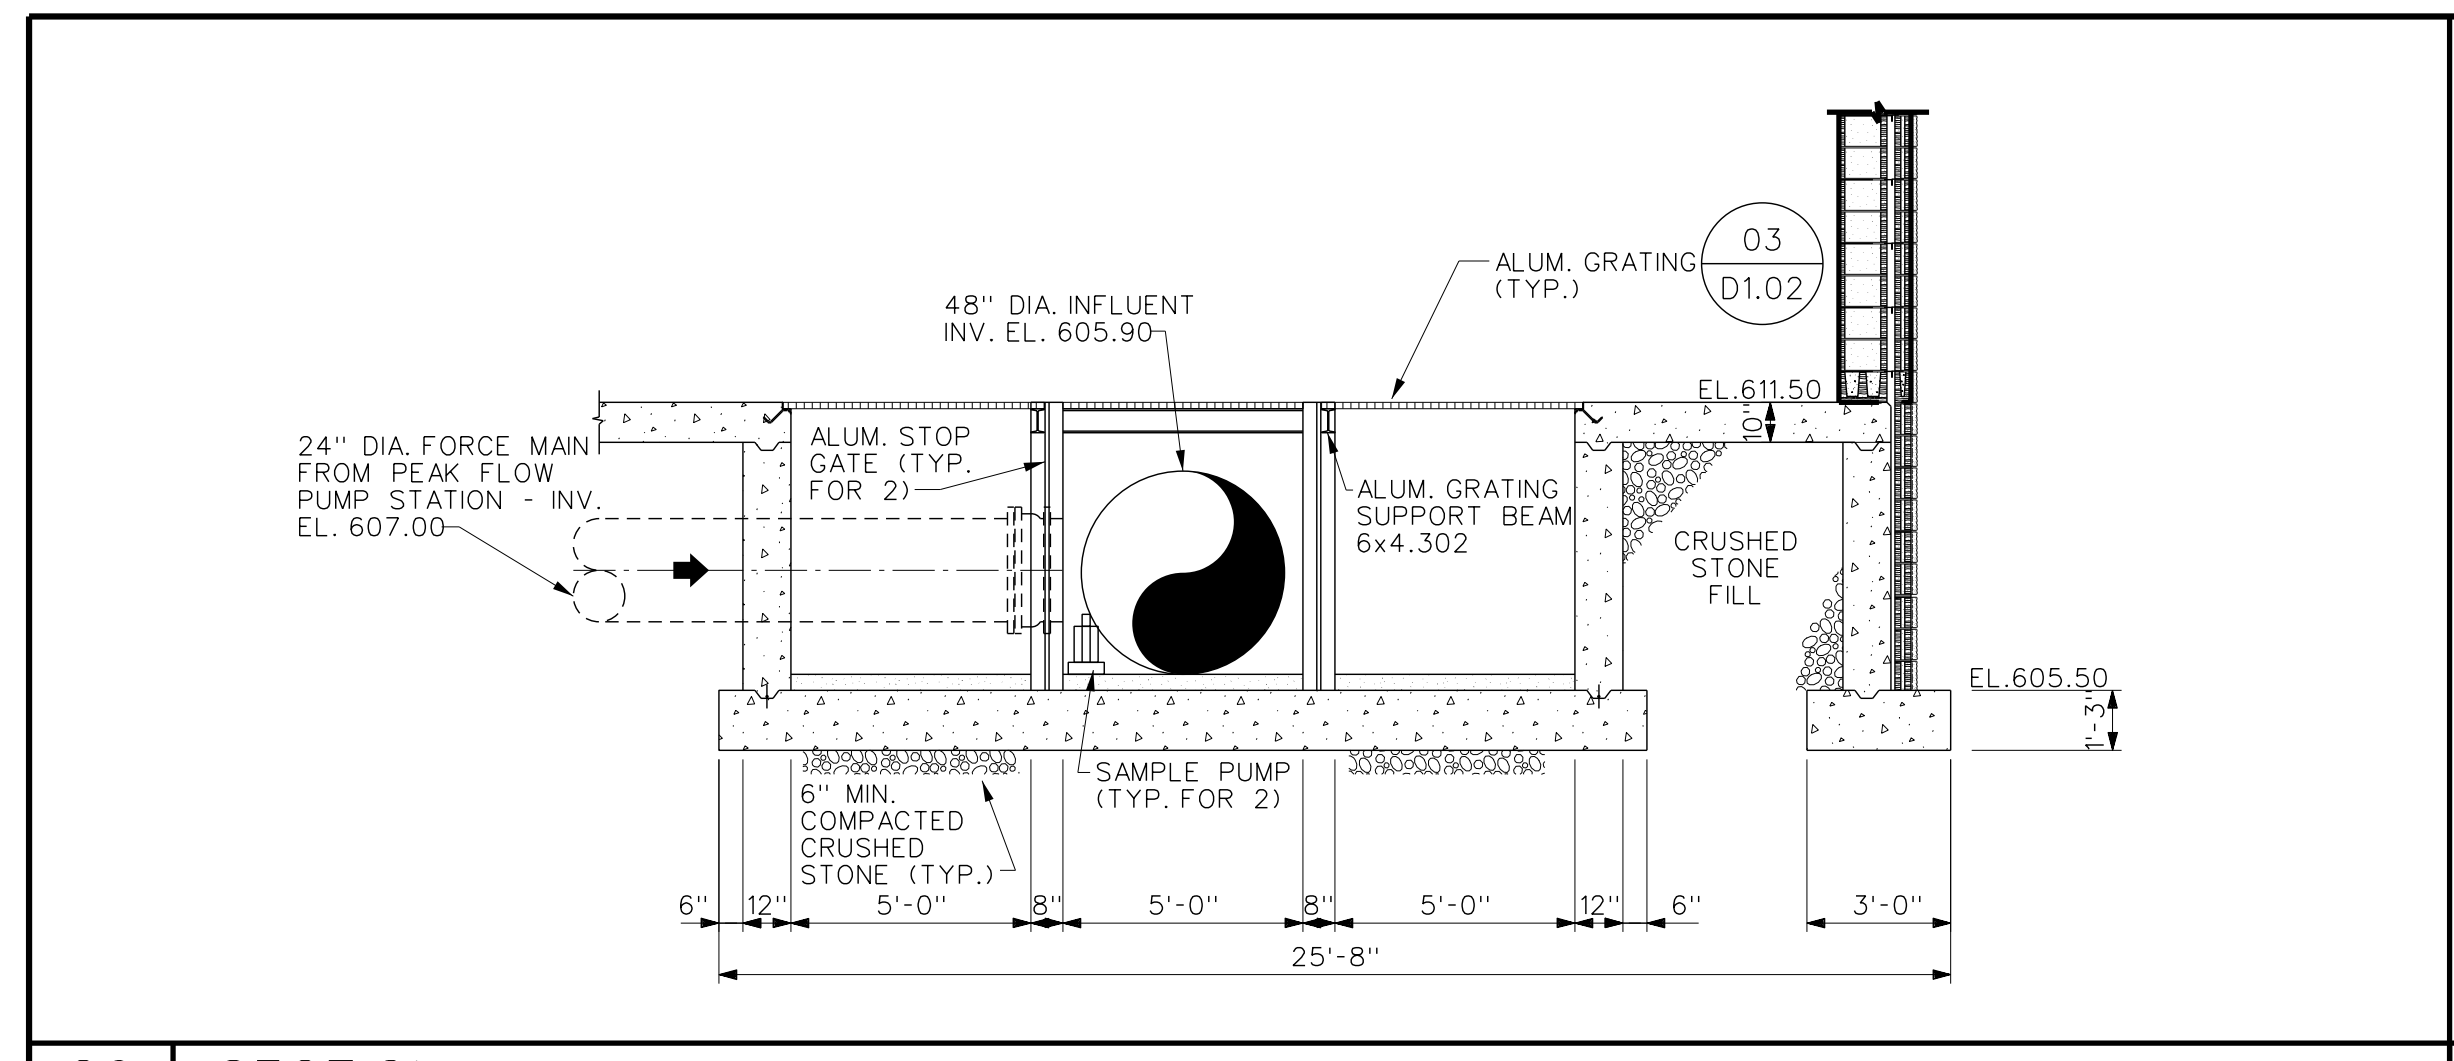

20 SECTION SCALE: 1/4" = 1'-0"

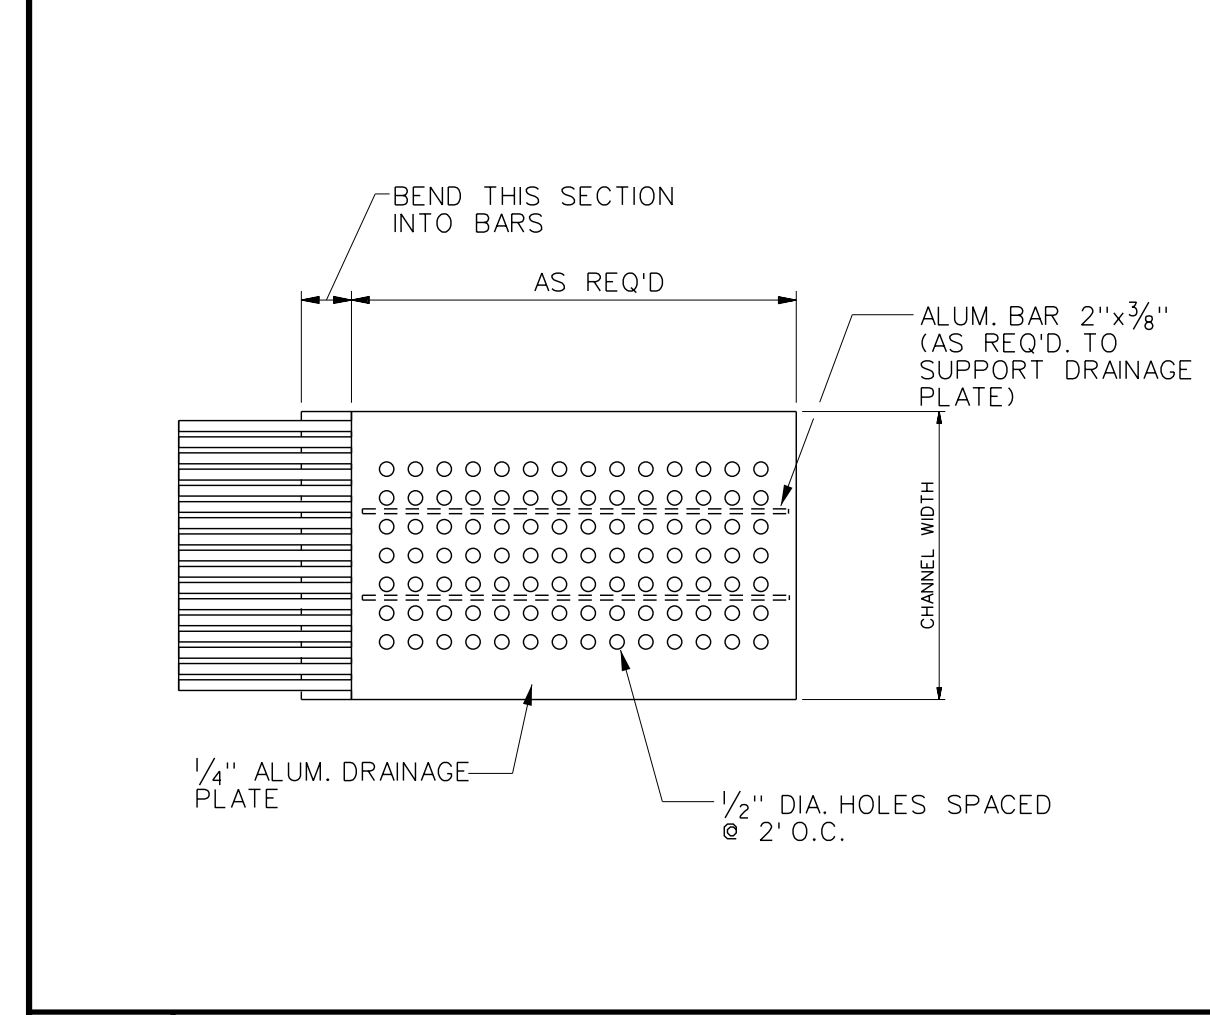


15 DRAINAGE PLATE DETAIL NO SCALE

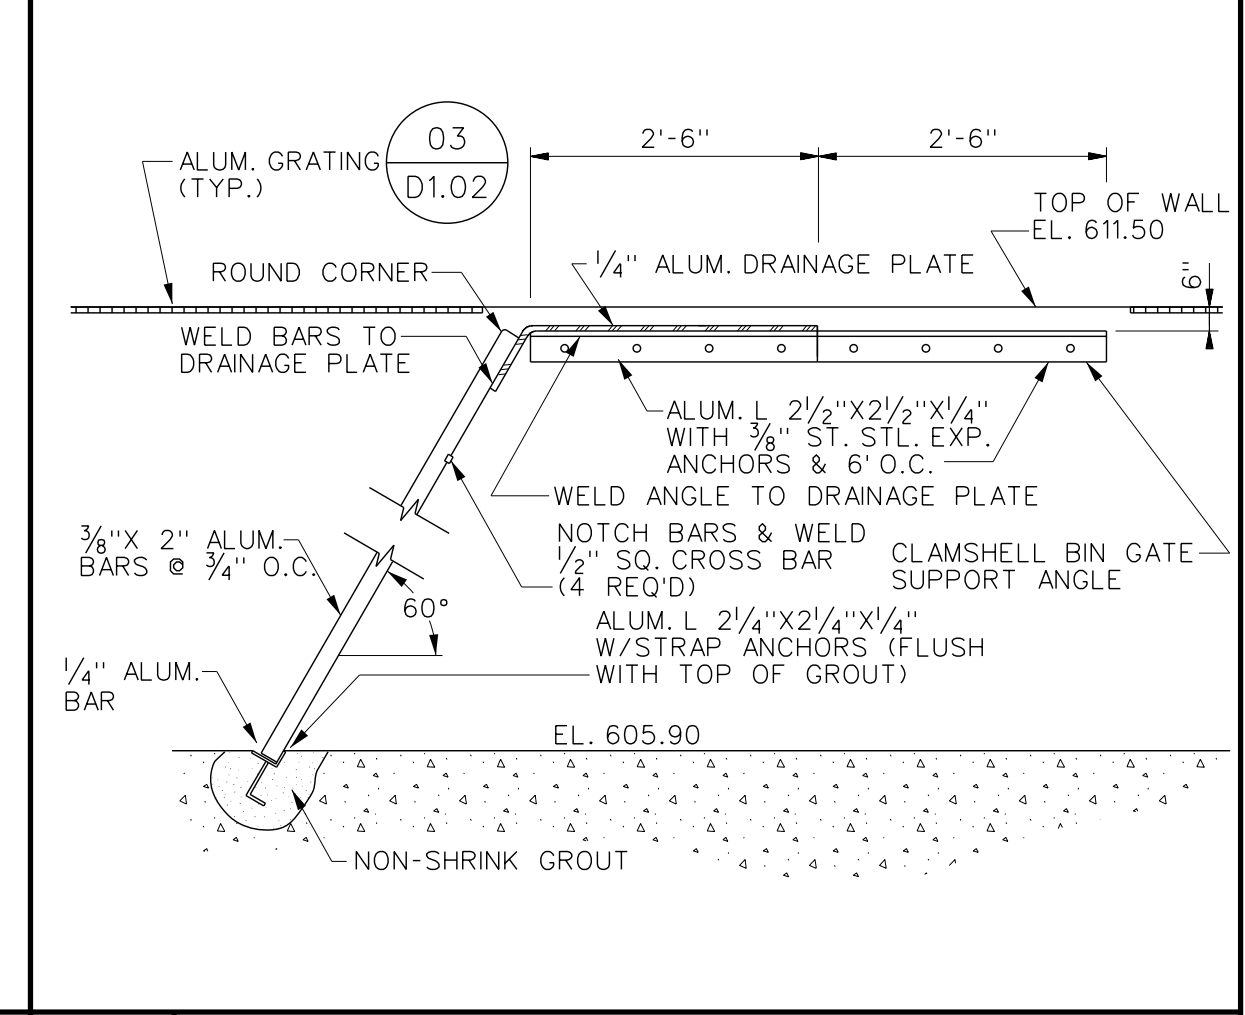


14 BAR SCREEN NO SCALE

- 1 48" D.I. WALL PIPE, PE-WS-MJ
- 2 24" D.I. WALL PIPE, PE-WS-MJ, INV. EL. 607.00
- 3 4" D.I. WYE, MJ
- 4 4" D.I. WALL PIPE, PE-WS-MJ
- 5 4" D.I. CROSS, ALL FLG
- 6 4" D.I. 90° BEND, FLG-FLG
- 7 4" D.I. BLIND FLANGE
- 8 4" D.I. PIPE, FLG-VGER
- 9 4" D.I. GATE VALVE, FLG-FLG
- 10 4" VICTAULIC COUPLING
- 11 4" D.I. 90° BEND, MJ-MJ
- 12 4" D.I. WALL PIPE, PE-WS-FLG

04 FITTINGS LIST NO SCALE

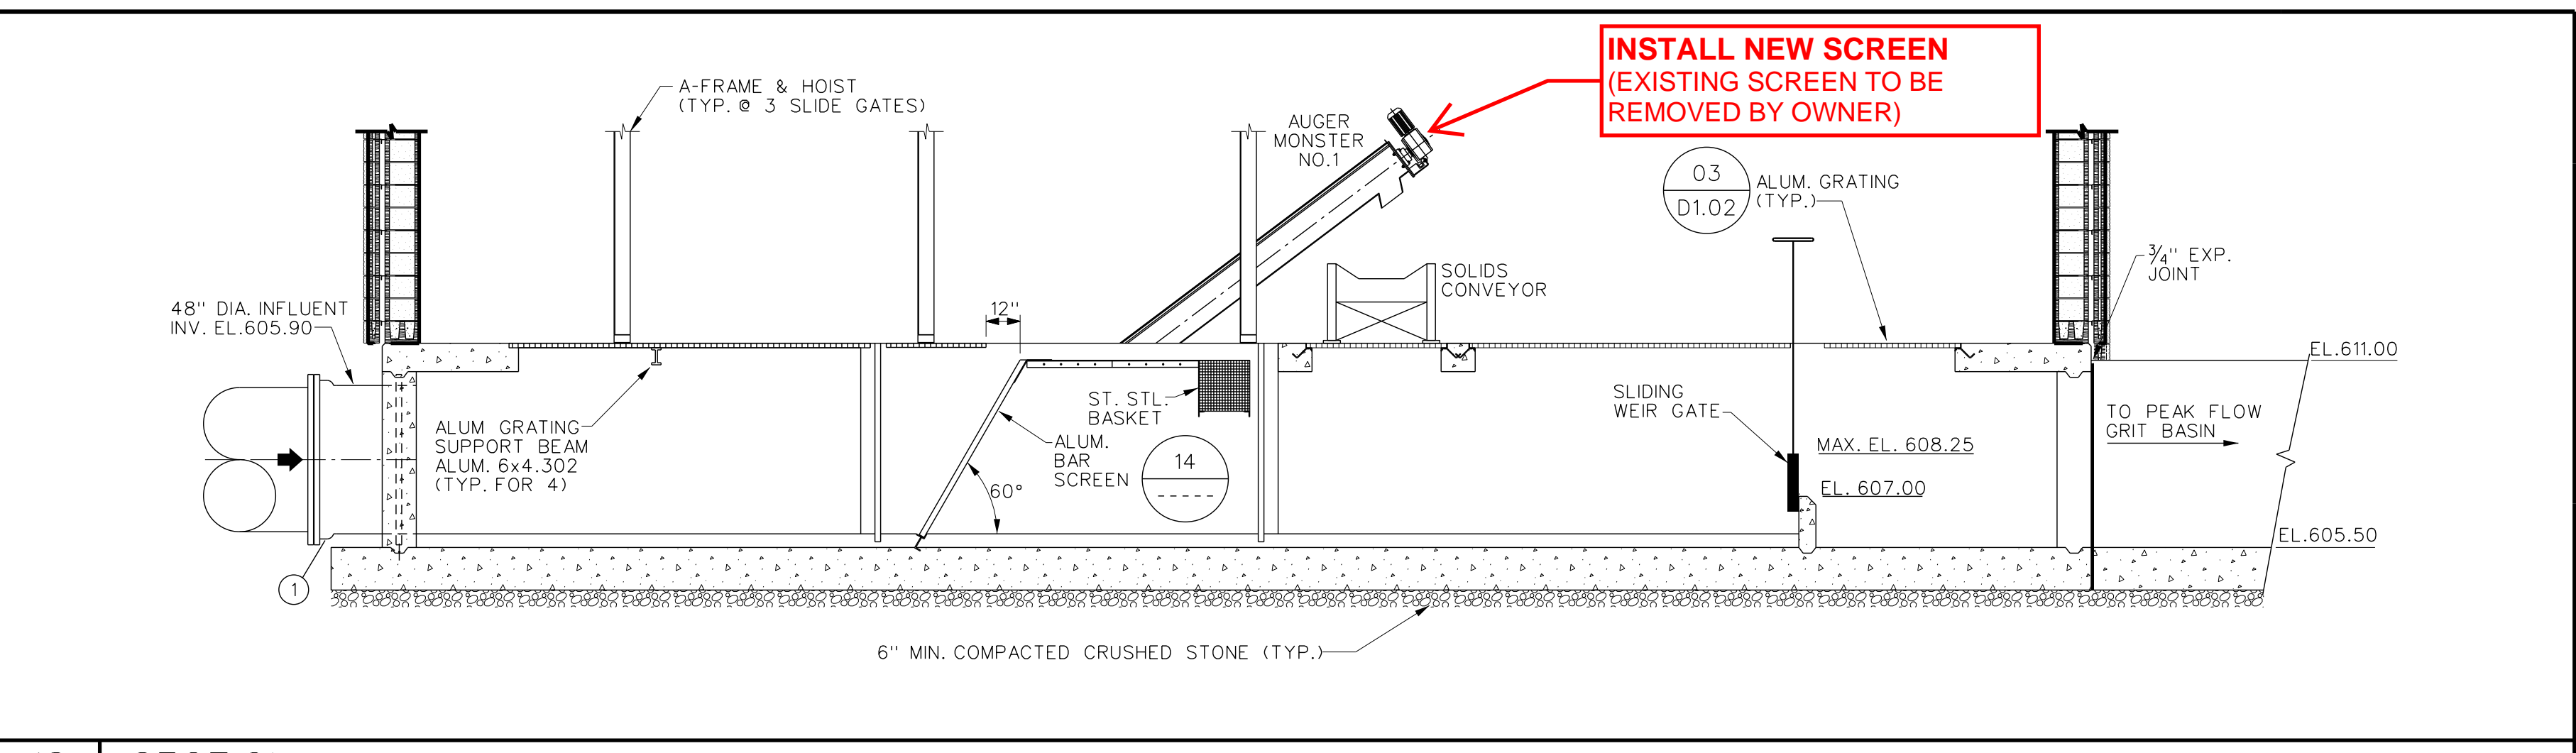

18 SECTION SCALE: 1/4" = 1'-0"

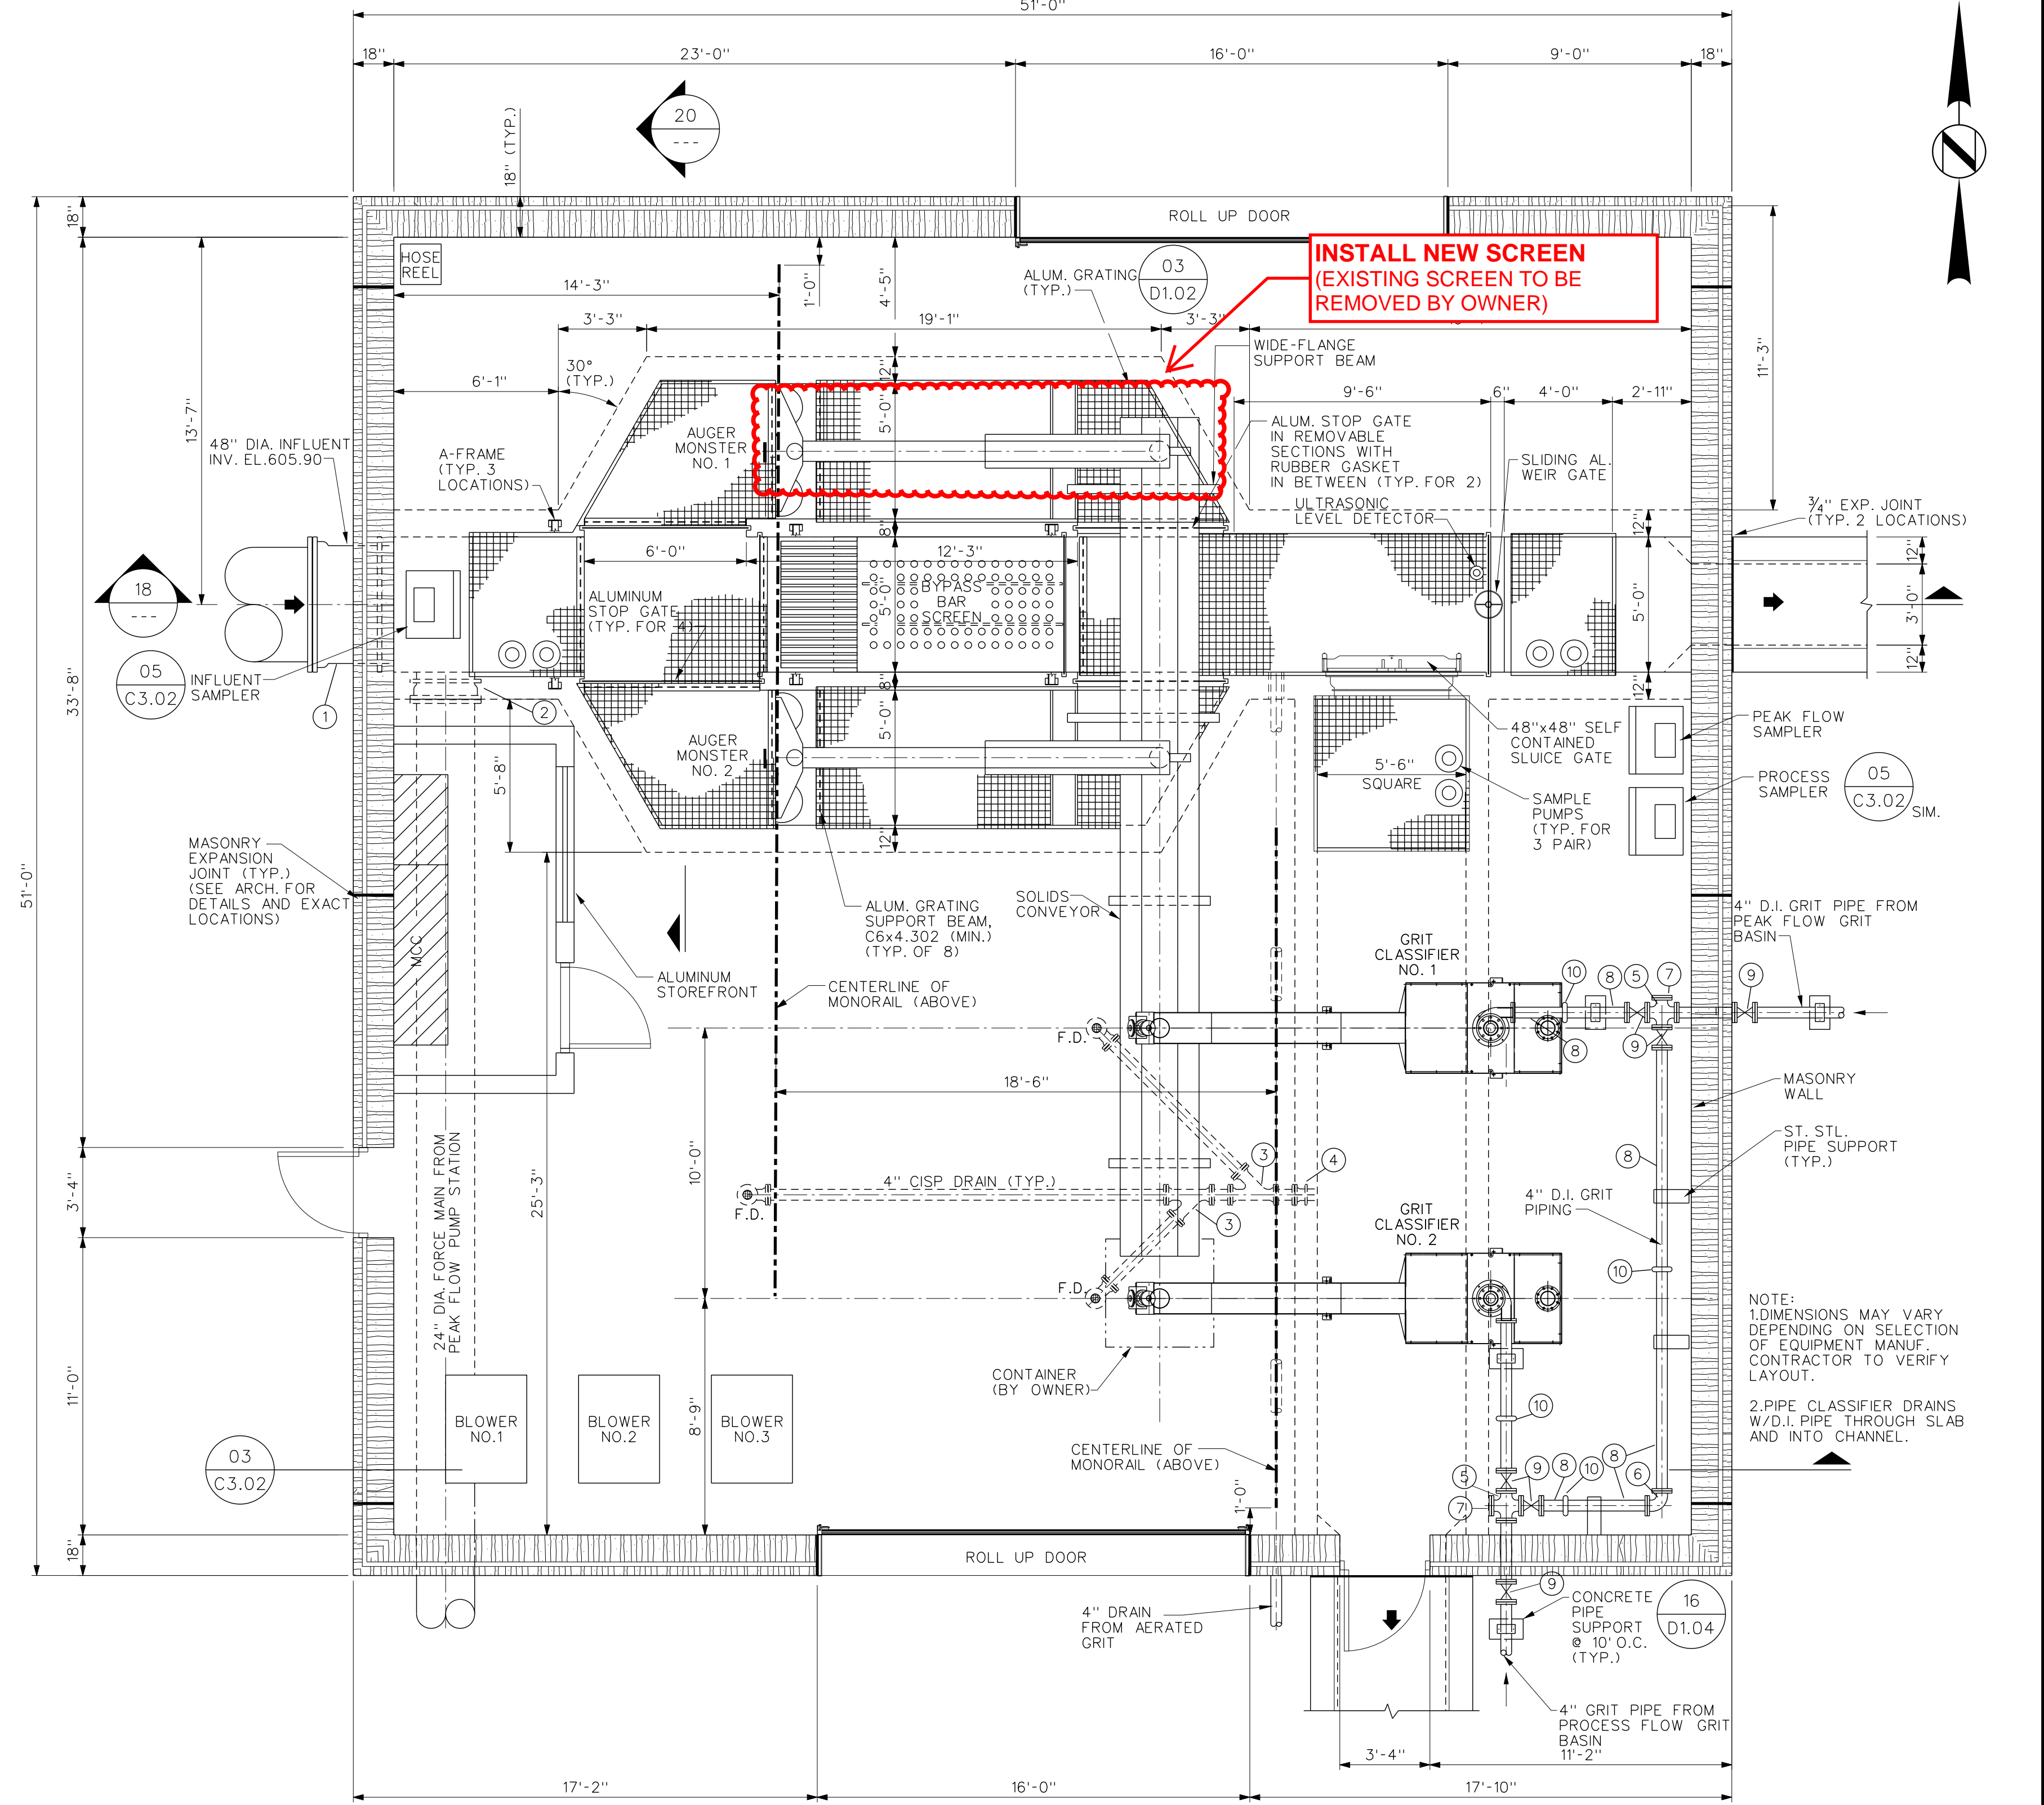

03 PLAN SCALE: 1/4" = 1'-0"

9/7/2006 11:17:43 PM C:\Program Files\Autodesk\AutoCAD 2006\AutoCAD.exe -c:\p\proj\98062\c3.dwg