


WATER WORKS & SEWER BOARD  
 CITY OF ANNISTON  
 CHOCOLOCOO WWTP  
 IMPROVEMENTS  
 ANNISTON, ALABAMA

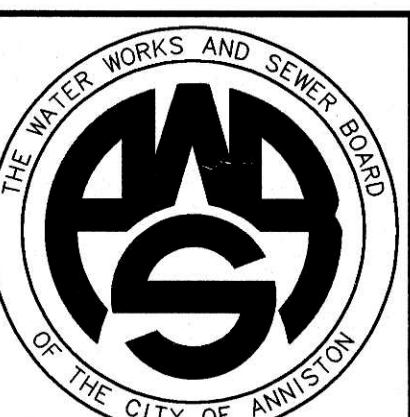



PROJECT NO.	98062	
DESIGNED	WCR	
DRAWN	CAB	
CHECKED	WCR	
APPROVED		
DATE	JULY 1999	
REVISIONS		
NO.	DATE	DESCRIPTION
1	11-17-06	RECORD DRAWING

RECORD DRAWING

SHEET TITLE  
**HEADWORKS BUILDING ELECTRICAL PLANS**


SHEET NO.  
**E3.01**

SEQUENCE  
 79 OF 84

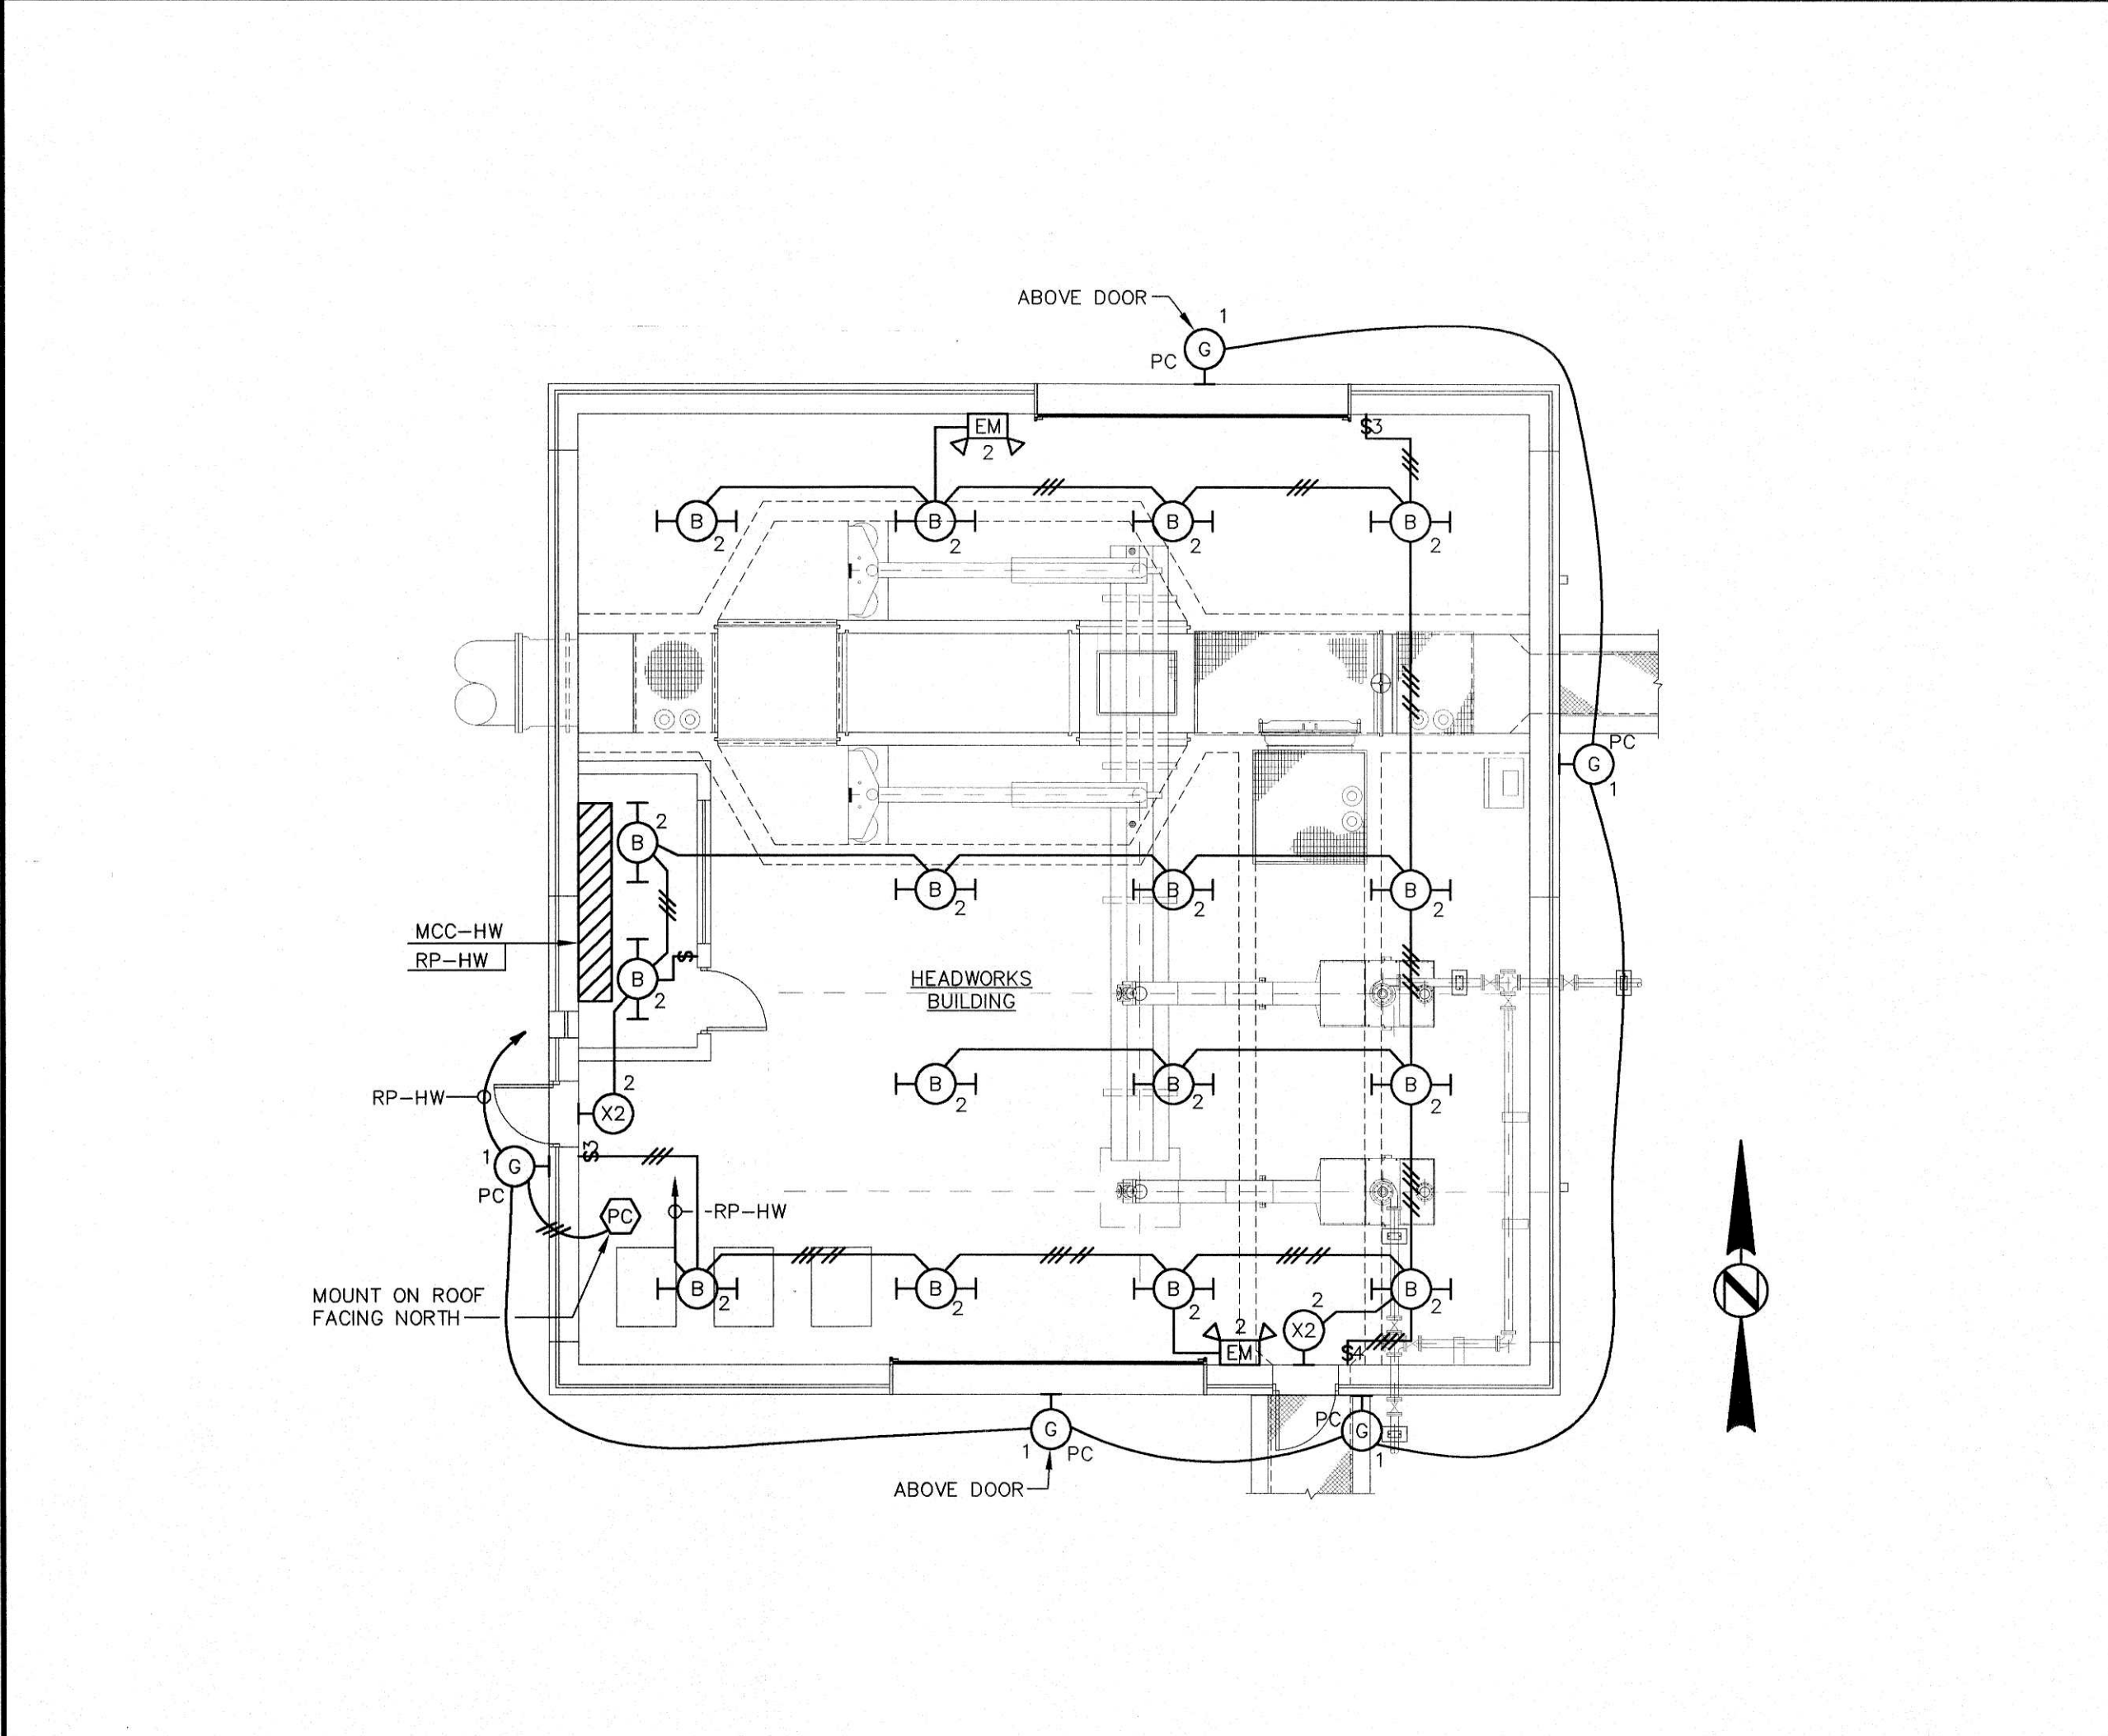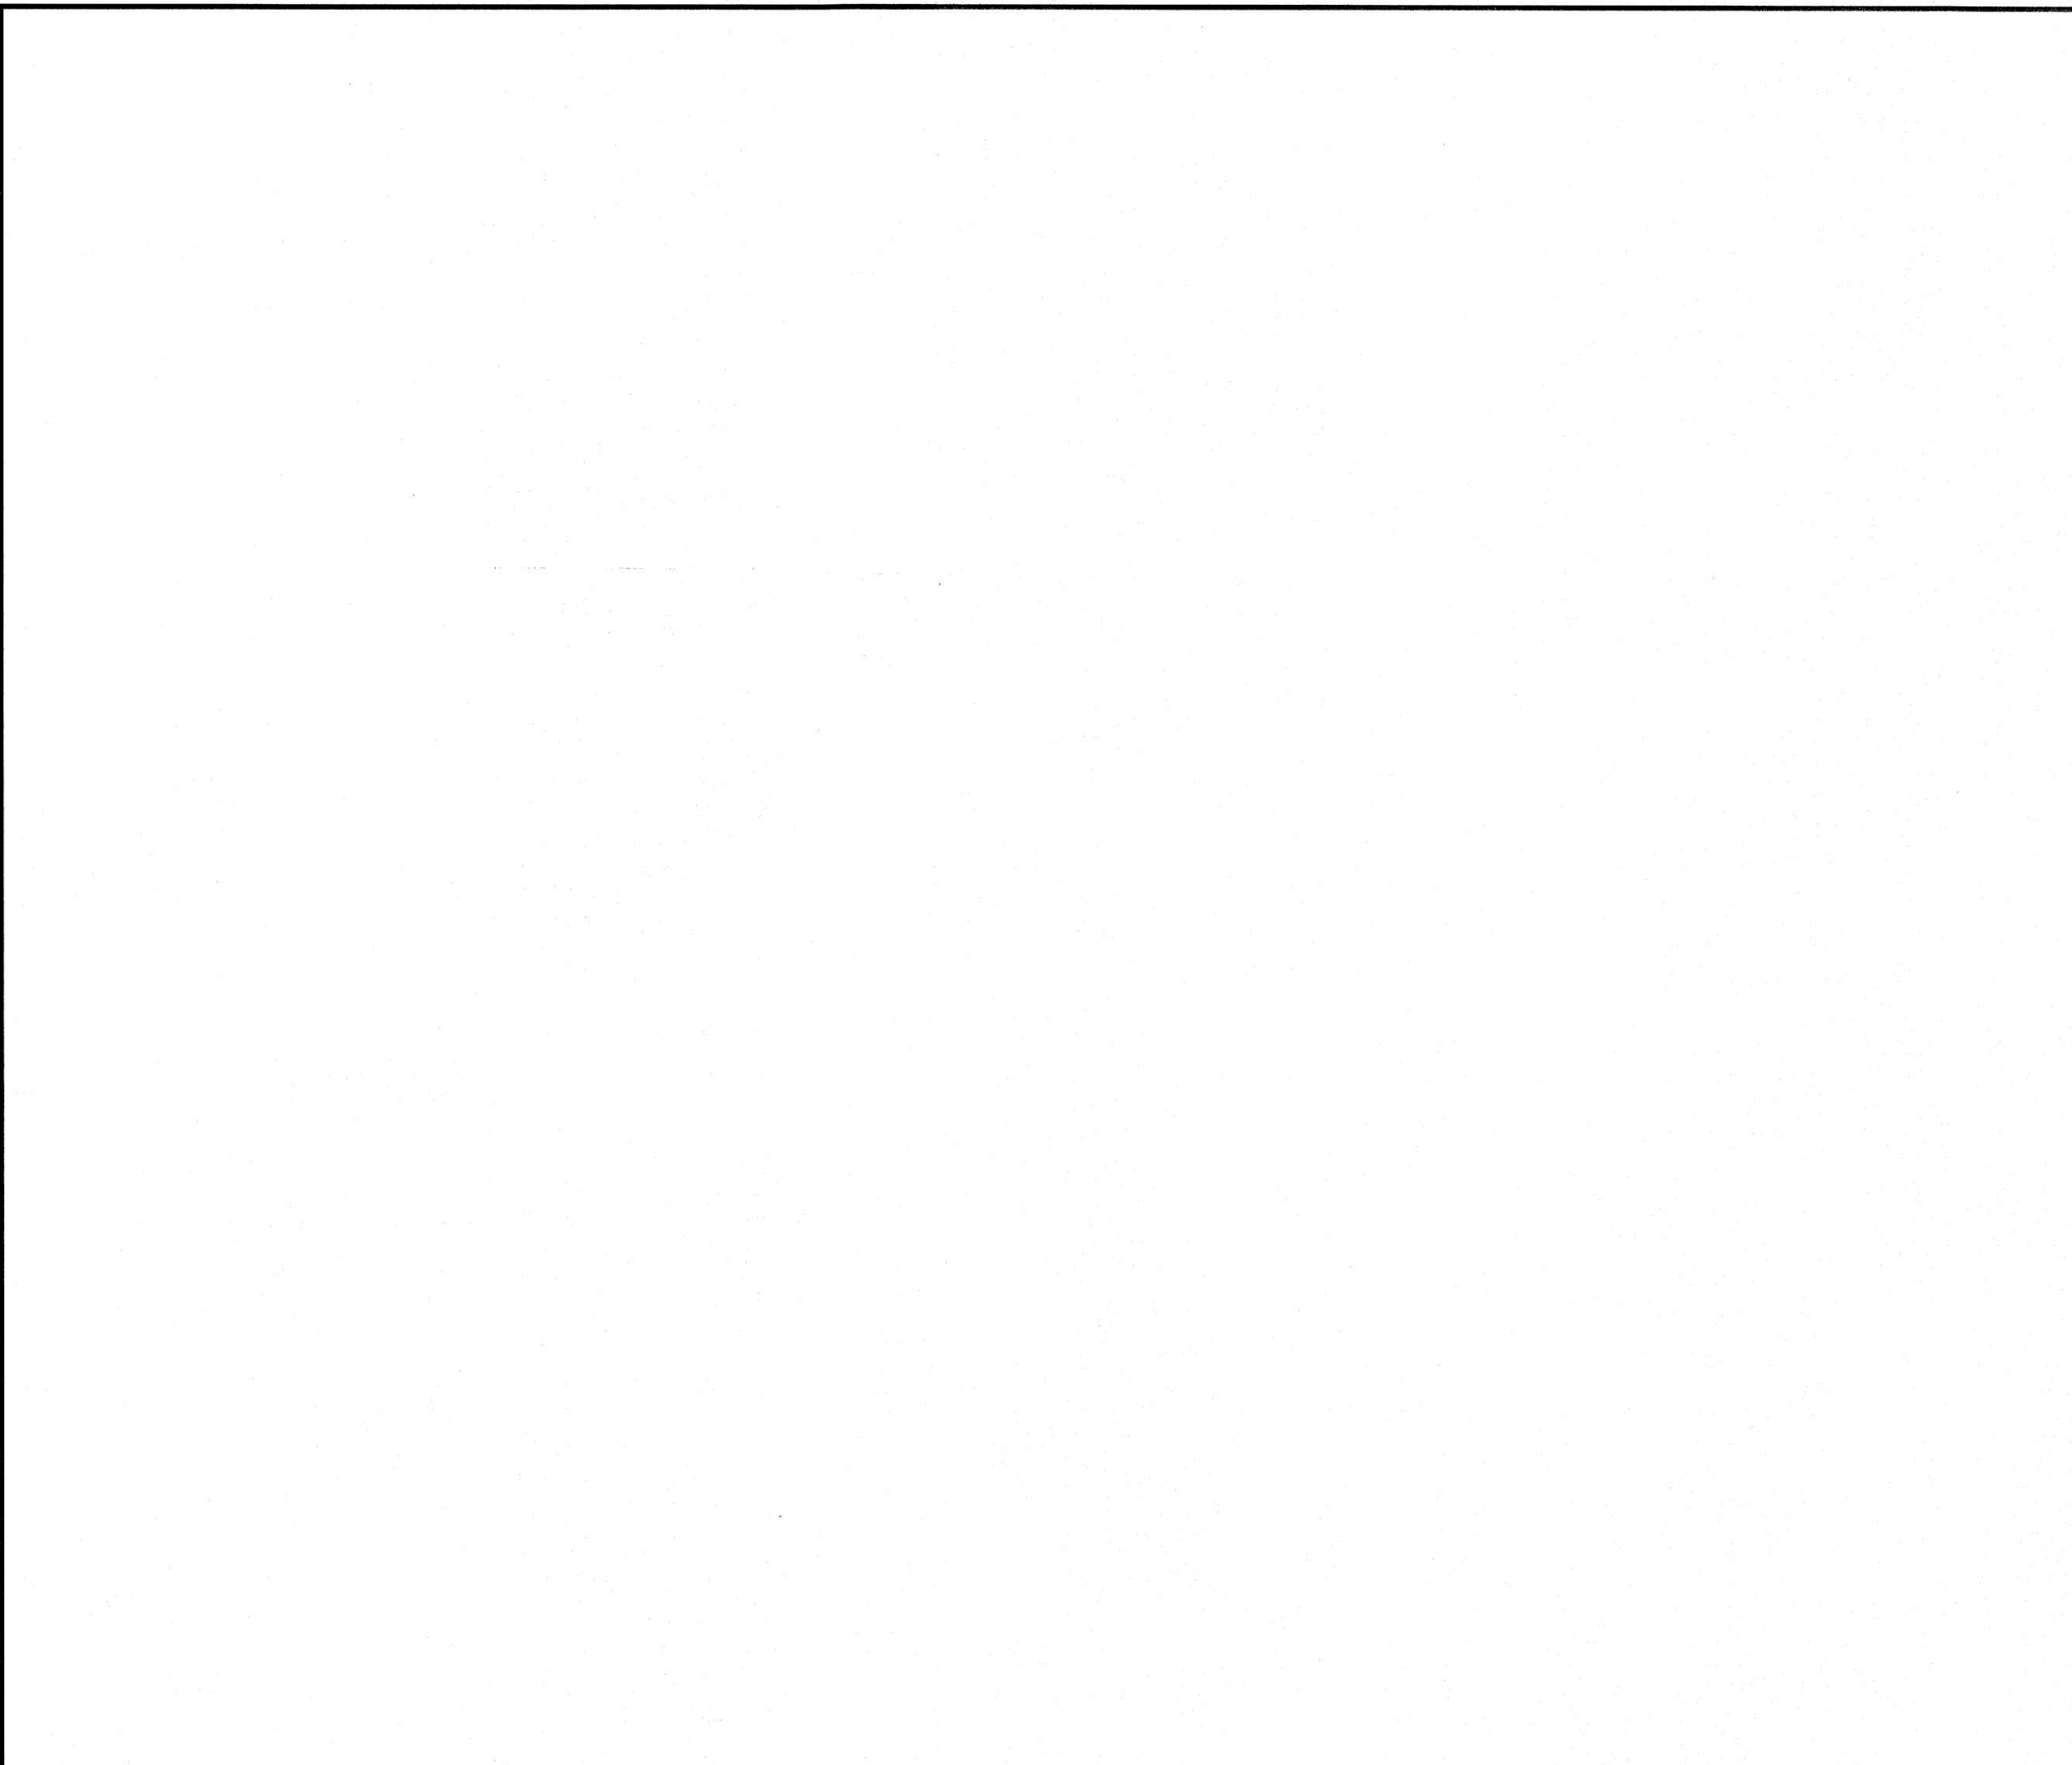

05 HEADWORKS BUILDING LIGHTING PLAN

SCALE : 1/8" = 1'-0"

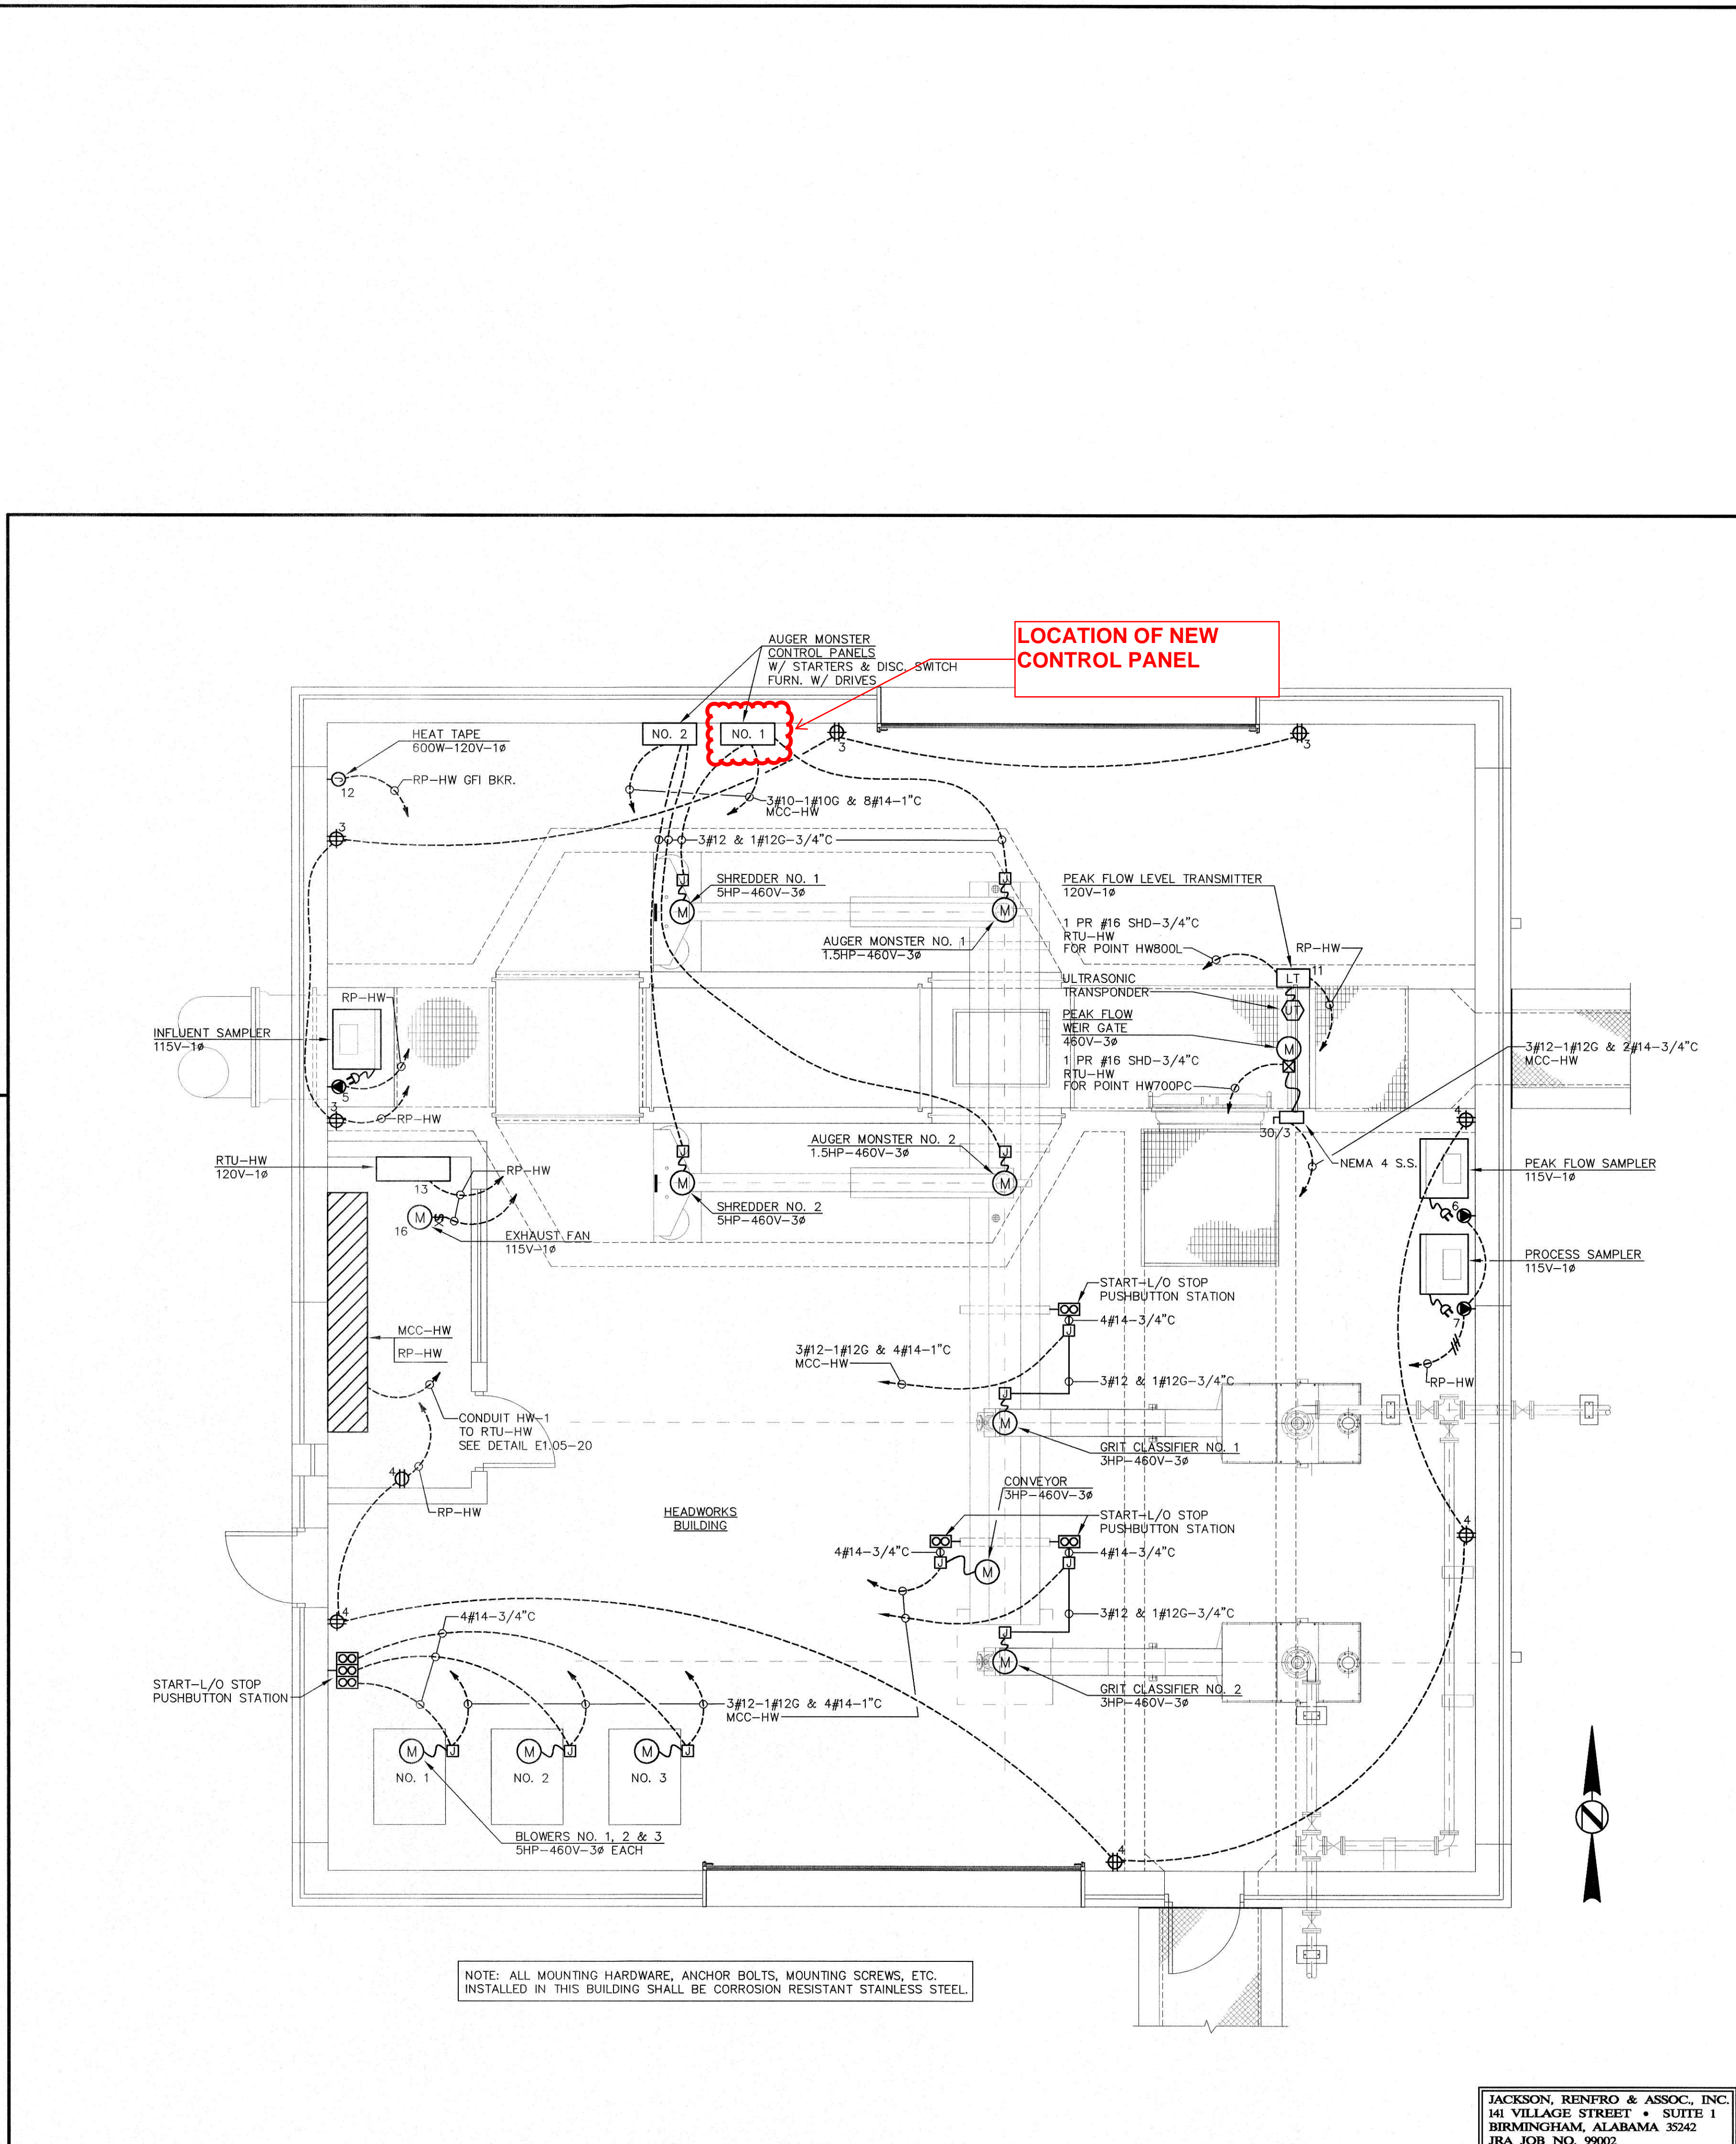

03 HEADWORKS BUILDING POWER PLAN

JACKSON, RENFRO & ASSOC., INC.  
 141 VILLAGE STREET • SUITE 1  
 BIRMINGHAM, ALABAMA 35242  
 JRA JOB NO. 99002

SCALE : 1/4" = 1'-0"