


20 | SECTION SCALE:1/4"=1'-0"

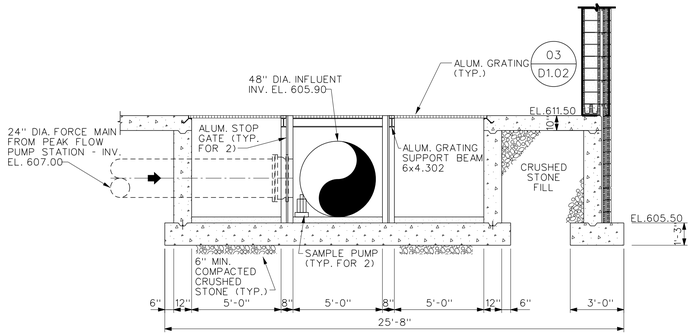


18 | SECTION SCALE:1/4"=1'-0"




15 | DRAINAGE PLATE DETAIL NO SCALE

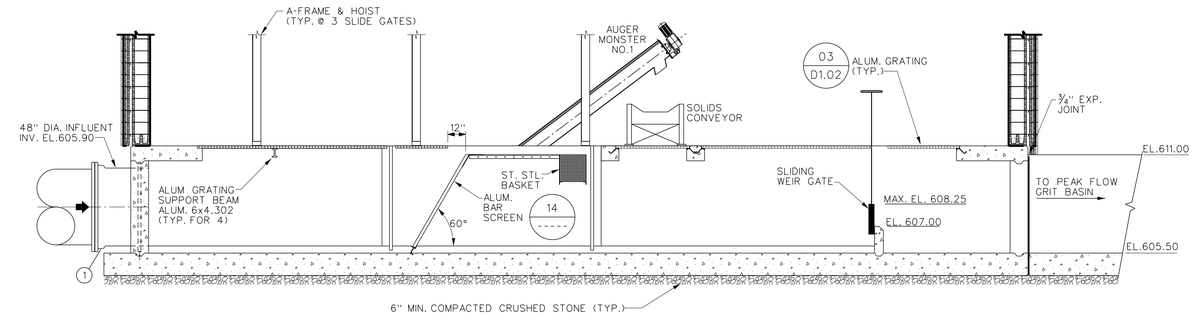


14 | BAR SCREEN NO SCALE

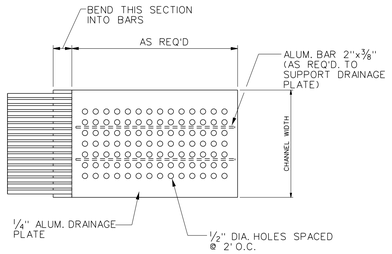


03 | PLAN SCALE:1/4"=1'-0"

(1) 48" D.I. WALL PIPE, PE-WS-MJ
(2) 24" D.I. WALL PIPE, PE-WS-MJ, INV. EL. 607.00
(3) 4" D.I. WYE, MJ
(4) 4" D.I. WALL PIPE, PE-WS-MJ
(5) 4" D.I. CROSS, ALL FLG
(6) 4" D.I. 90° BEND, FLG-FLG
(7) 4" D.I. BLIND FLANGE
(8) 4" D.I. PIPE, FLG-VGER
(9) 4" D.I. GATE VALVE, FLG-FLG
(10) 4" VICTAULIC COUPLING
(11) 4" D.I. 90° BEND, MJ-MJ
(12) 4" D.I. WALL PIPE, PE-WS-FLG

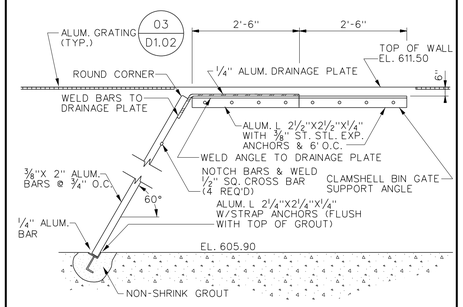04 | FITIINGS LIST NO SCALE

8/14/2013
Admin
P:\Civil\Anniston_eng\anniston\98062_civil\record_dwgs\98062s301.dgn

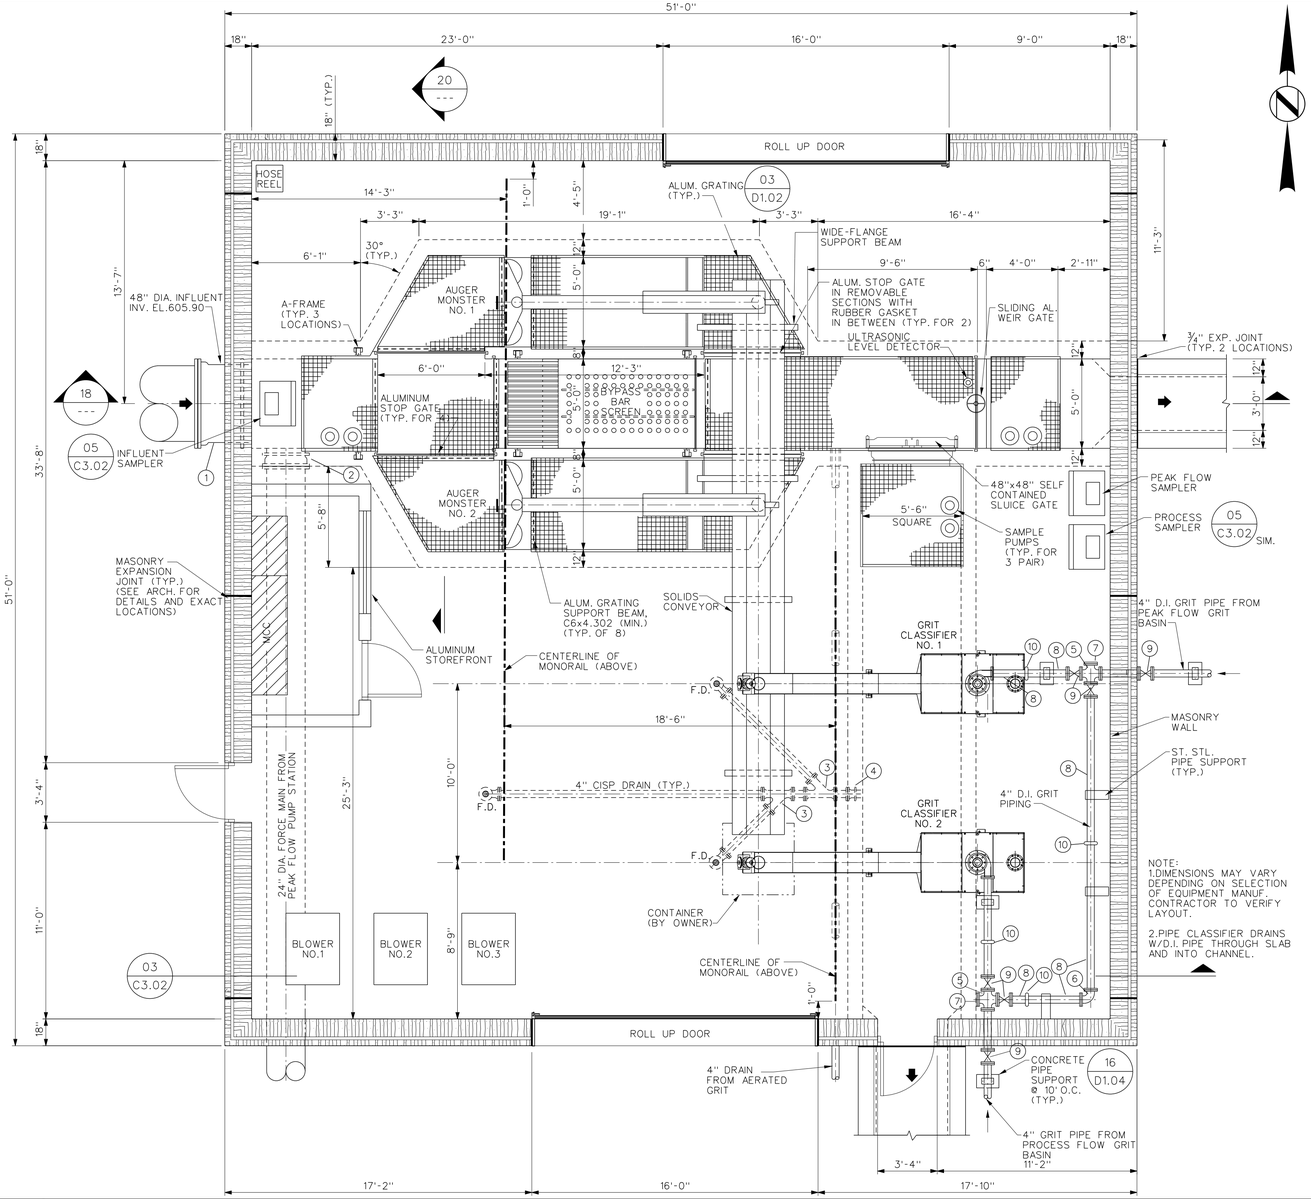KREBS
ARCHITECTURE / ENGINEERING
BIRMINGHAM · ALBANY · MONTGOMERY

ALABAMA REGISTERED NO. 15757 PROFESSIONAL ENGINEER PAUL G. RAY

WATER WORKS & SEWER BOARD
CITY OF ANNISTON
CHOCCOLOCCO WWTP
IMPROVEMENTS
ANNISTON, ALABAMA

THE WATER WORKS AND SEWER BOARD OF THE CITY OF ANNISTON

| | |
|---|---|
| PROJECT NO. | 98062 |
| DESIGNED | PGR |
| DRAWN | MDS |
| CHECKED | RUH |
| APPROVED | |
| DATE | JULY, 1999 |

REVISIONS

| NO. | DATE | DESCRIPTION |
|---|---|---|
| 1 | NOV. 2006 | RECORD DRAWING |

RECORD DRAWING

SHEET TITLE
HEADWORKS
BUILDING MECHANICAL
PLAN & SECTIONS

SHEET NO.
C3.01

SEQUENCE 29 OF 84

© 2006 PAUL B. KREBS & ASSOCIATES, INC.